

Name Fiske School

Service No.

Address Off Adams Street
34A Colony St.
Lexington, Mass.34A Colony Road
Location Off Adams Street

Kind of Pipe Com. 3-7-49

Size

Size of Main

~~REPAIR WORK~~—New Service

Location

Date	Material	Amount	Total	Date	Amount
Dec. 31, '48	Labor	42 33			
Jan. 1, '49	"	<u>22 70</u>	65 03	April 14, '49	181 31
	10% Overhead		6 50		
	38' - 6" C. L. Pipe @ 1.63		61 94		
	1 - 2" W. H. Gate Valve		6 40		
	Leadite & Jute		2 00		
	1 - 6" Plug Tapped 2"		11 08		
	1 - 2" L. L. Elbow		1 22		
	2 - 2" C. L. Nipples 4" long		72		
	1 - 2" C L Nipples 6" long		52		
	1 - 2" C. L. Nipples 10" long		90		
	2½ hrs. Shovel @ 7.00		17 50		
	Labor 2 hrs. D4 Trac. @ 3.00		6 00		
	Trucking 2 hrs. @ .75		<u>1 50</u>		
			181 31		

*No Deposit
Paid*

TOWN OF LEXINGTON – BOARD OF PUBLIC WORKS

WATER DIVISION

The undersigned applies for a supply of water at No..... St. and hereby agrees to comply with the rules and regulations as now, or at any future time, established by the Board of Selectmen.

Am't of Estimate \$.....


Owner

Am't Paid \$.....

Address

Builder

.....

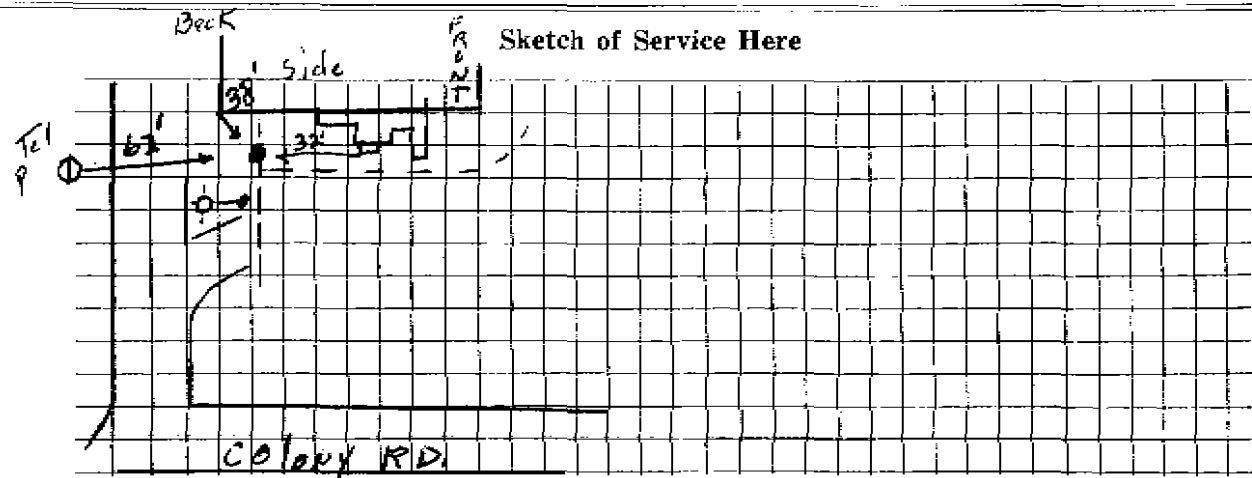

Connection made in Street.

Work completed19

Remarks: