

Name James McDevitt
 Address 36 Colony Road
 Lexington, Mass.

Service No. 174 #5100

Locatic 36 Colony Road

Kind of Pipe

Size

Size of Main

~~Repair - Renewal~~ - New Service

Com. 9-5-50

Location

Date	Material	Amount	Total	Date	Amount
Jul. 29, '50	Labor	1 30	1 30	July 18, '50	25 00
	10% Overhead		13		
	57' - 3/4" Copper Tubing @.23		13 11		
	1 - 3/4" C x 1/2" I.W.H. S&W		3 29	Jul. 29, '50	4 67
	Trucking 1 hr. @.75		75	9' - 3/4" Copper Tubing @.23	2 07
			18 58	1 - 3/4" C Corp-cock	3 15
				1 - 3/4" C x 3/4" C Curb-cock	3 85
				1 - Box & Rod	3 35
				1 - 1/2" Offset Tail Piece	38
				1 - 1/2" Straight Tail Piece	38
				Littlefield Shovel 1 1/2 hrs. @7.00	10 50
				Trucking 1 hr. @.75	75
	Labor				29 10

Deposited

No Charge

Hadley Press, Inc., Lexington

DATE _____

TOWN OF LEXINGTON—BOARD OF PUBLIC WORKS

WATER DIVISION

The undersigned applies for a supply of water at No. _____ St. and hereby agrees to comply with the rules and regulations as now, or at any future time, established by the Board of Selectmen.

Am't. of Estimate \$ _____


Owner _____

Am't. Paid \$ _____

Address _____

Builder _____

Sketch of Service Here

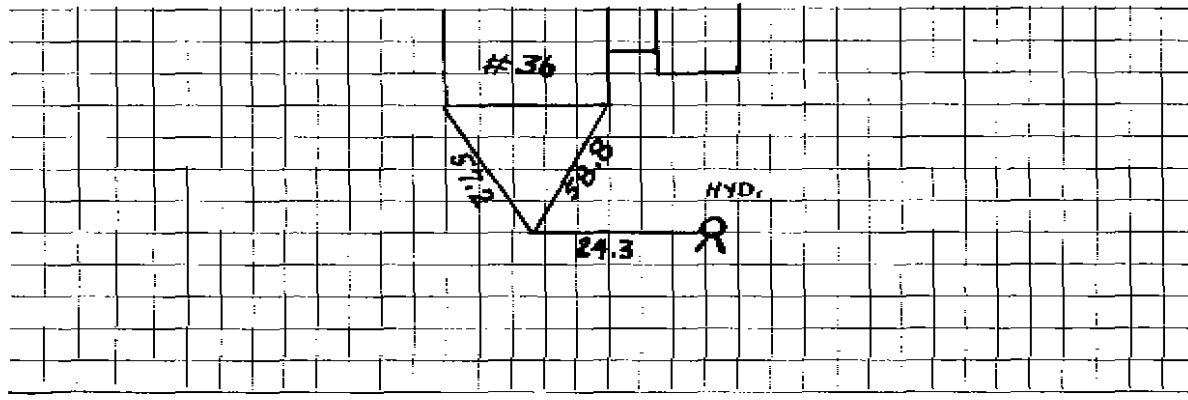

Connection made in _____ Street.

Work completed _____ 19

Remarks: