

Name Elizabeth M. Burton
 Address 38 Colony Road, Lexington, Mass.

Service No. 609
 2888

Kind of Pipe Location Size Size of Main
 Repair—Renewal—New Service Location

Date	Material	Amount	Total	Date	Amount
1940					
1/20/40	Permanent Service:				
	35 1/2 hrs. @ 55¢	19 53		<i>February 16, 1940 Paid</i>	122 35
	8 3/8 " @ 60¢	5 10			
	1 " @ 65¢	65			
	6 1/2 " @ 70¢	4 55	29 83		
	10% Overhead		2 98		
	75' 3/4" Copper tubing @ 17¢		12 75		
	1 3/4" S. & W.		2 05		
	1 3/4" C. Union (3 parts)		88		
	Compressor		10 00		
	Trucking 4 hrs. @ 75¢		3 00		
	Temporary Service:				
	4 hrs. @ 50¢	2 00			
	25 " @ 55¢	13 75			
	30 " @ 60¢	18 00			
	4 " @ 65¢	2 60	36 35		
	10% Overhead		3 64		
	2 Labor hrs. trucking @ 75¢		1 50		
	Removing temporary service		7 66		
	Plumber's bill (Lester Andrews)		11 71		
			122 35		

Madley Press, Inc., Lexington

DATE _____

TOWN OF LEXINGTON — BOARD OF PUBLIC WORKS

WATER DIVISION

The undersigned applies for a supply of water at No. 37 St. and hereby agrees to comply with the rules and regulations as now, or at any future time, established by the Board of Selectmen.

Am't. of Estimate \$ _____


Owner Elizabeth M. Burton

Am't. Paid \$ _____

Address 38 Colony Rd
Lexington

Builder _____

Sketch of Service Here

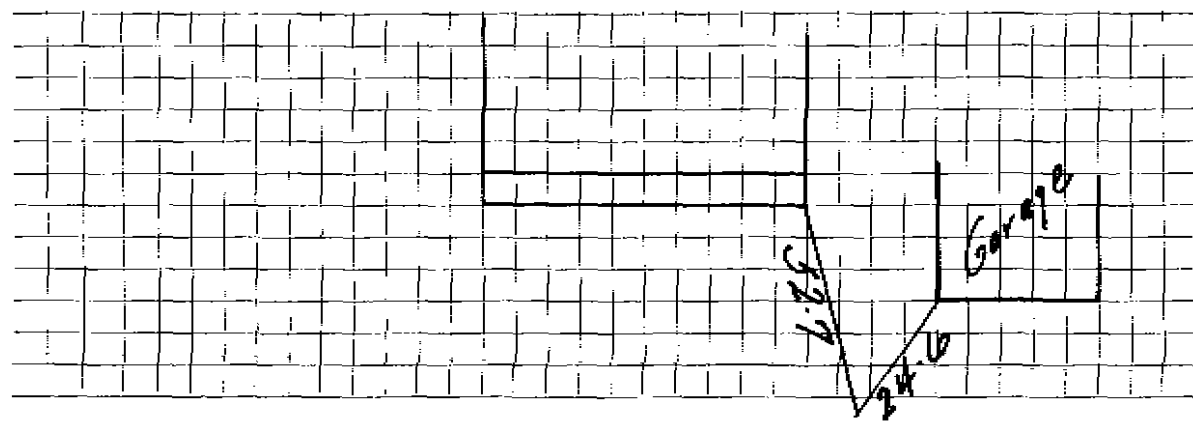

Connection made in _____ Street.

Work completed _____ 19__

Remarks: