

Name *Amerson Day*
 Address *39 Colony Road*
Lexington, Mass.

Service No. *#2376*
#2377

Location *39 Colony Road*

Kind of Pipe _____ Size _____ Size of Main _____

Repair ~~Renewal~~ ~~New Service~~

Location _____

Date	Material	Amount	Total	Date	Amount
<i>Sept. 16, '48</i>	Labor	<i>19.00</i>	<i>19.58</i>	<i>Sept. 1, 48</i>	<i>59.90</i>
	100% Overhead		<i>1.06</i>	<i>Deposited</i>	
	20' - 3/4" Copper tubing	<i>7.25</i>	<i>9.60</i>	<i>Pen-Charge</i>	<i>97.23</i>
	1 - 3/4" C x 3/4" U.F.C.	<i>3.75</i>	<i>3.15</i>	<i>Sept. 16, '48</i>	<i>5.20</i>
	Littlefield Shovel 2 hrs.	<i>27.00</i>	<i>31.00</i>	27' - 3/4" Copper tubing	<i>7.25</i>
	Trucking 1 hr.	<i>1.75</i>	<i>15.15</i>	1 - 2/1" C Corp-cock	<i>3.00</i>
			<i>39.23</i>	1 - 3/4" C x 3/4" C Corp-cock	<i>3.68</i>
				1 - 3/4" C x 3/4" Union (1/2)	<i>1.32</i>
				1 - Box x 400	<i>3.55</i>
				Littlefield Shovel 1 hr.	<i>7.00</i>
				1 - 1" Offset Tail Piece	<i>3.00</i>
				1 - 3" Straight Tail Piece	<i>3.00</i>
				Trucking 1 hr.	<i>1.75</i>
					<i>75</i>
					<i>31.99</i>

Hadley Press, Inc., Lexington

Amerson Day

Labor

DATE _____

TOWN OF LEXINGTON—BOARD OF PUBLIC WORKS

WATER DIVISION

The undersigned applies for a supply of water at No. _____ St. and hereby agrees to comply with the rules and regulations as now, or at any future time, established by the Board of Selectmen.

Am't. of Estimate \$ _____


Owner _____

Am't. Paid \$ _____

Address _____

Builder _____

Sketch of Service Here

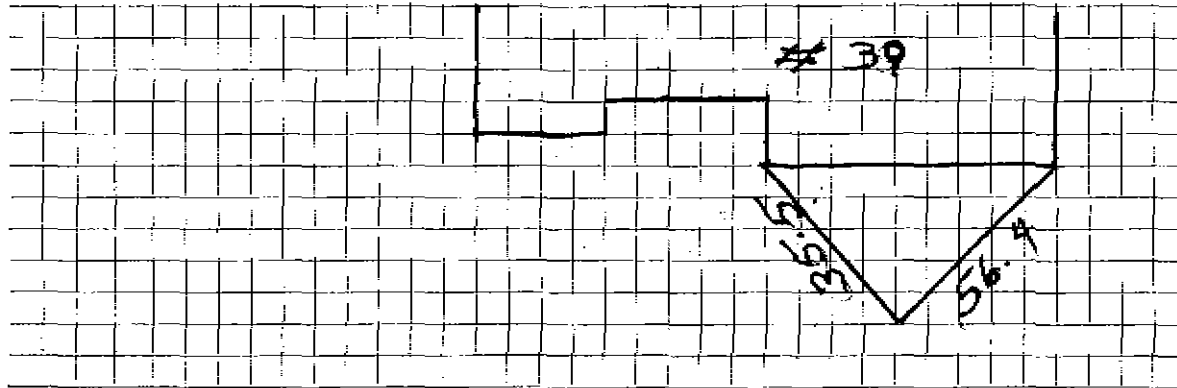

Connection made in _____ Street. Work completed _____ 19

Remarks: