

Name Kenneth Sears

Service No. 19

Address 49 Colony Road
Lexington, Mass.

3541

Location 49 Colony Road

Kind of Pipe

Size

Size of Main

~~Repair-Renewal~~—New Service

Com. 9-26-49

Location

Date	Material	Amount	Total	Date	Amount
------	----------	--------	-------	------	--------

Aug. 4, '49	Labor	3 13	3 13	Aug. 4, '49	32 95
	10% Overhead		31		
	42' - 3/4" Copper Tubing @.24		10 08		
	1 - 3/4" C x 1/2" I.W.H. S&W		3 29	Aug. 4, '49	3 13
	1 - 3/4" C x 3/4" C Union (3pts)		1 39	22' - 3/4" Copper Tubing @.24	5 28
	Littlefield Shovel 2 hrs. @7.00		14 00	1 - 3/4" C Corp-cock	3 15
	Trucking 1 hr. @.75		75	1 - 3/4" C x 3/4" C Curb-cock	3 85
			32 95	1 - Box & Rod	3 95
				1 - 1/2" Offset Tail Piece	37
				1 - 1/2" Straight Tail Piece	37
				Littlefield Shovel 1 rh. @7.00	7 00
				Trucking 1 hr. @.75	75
	Labor				27 85

Deposited
~~No Deposit~~

No Charge

DATE _____

TOWN OF LEXINGTON - BOARD OF PUBLIC WORKS

WATER DIVISION

The undersigned applies for a supply of water at No. St. and hereby agrees to comply with the rules and regulations as now, or at any future time, established by the Board of Selectmen.

Am't of Estimate \$.....

Owner


Am't Paid \$.....

Address

Builder

.....

Sketch of Service Here

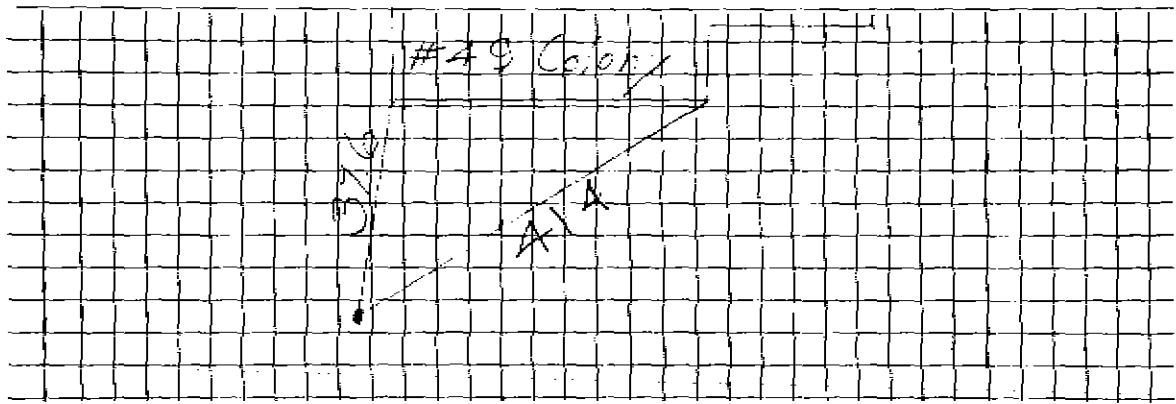

Connection made in Street.

Work completed19

Remarks: