

WATER SERVICE RECORD

Name Louis Stoico

Service No. 288

Address 5 Colony Road

Location

~~Repair - Renewal -~~ New Service


Class 34-61

Date	Material	Amount	Total	Date	Amount	
12-5-60	Labor	37.13		11-28-60	Deposit	100.00
	10% O.H.	3.71	40.84	6-30-61	Paid	3.67
48'	3/4" Copper tubing @.42		20.16			103.67
1	3/4" C x 1/2" I.W.H. Stop & Waste		6.17		NON CHARGE	
3	hrs. Pippin Shovel @4.50		13.50	12-5-60	Labor	19.34
2	hrs. Trucking @3.00		6.00	25'	3/4" Copper tubing @.42	10.50
17	x 3 Patch		17.00	1	3/4" C Corp Cock	4.91
			103.67	1	3/4" C Curb Cock	6.28
				1	Box & Rod	4.90
				1	1/2" Straight tailpiece	.50
				1	1/2" Offset tailpiece	.50
				1	hr. Pippin Shovel @4.50	4.50
				1	hr. Trucking @3.00	3.00
						54.43

TOWN OF LEXINGTON — BOARD OF PUBLIC WORKS

WATER DIVISION

Sketch of Service Here

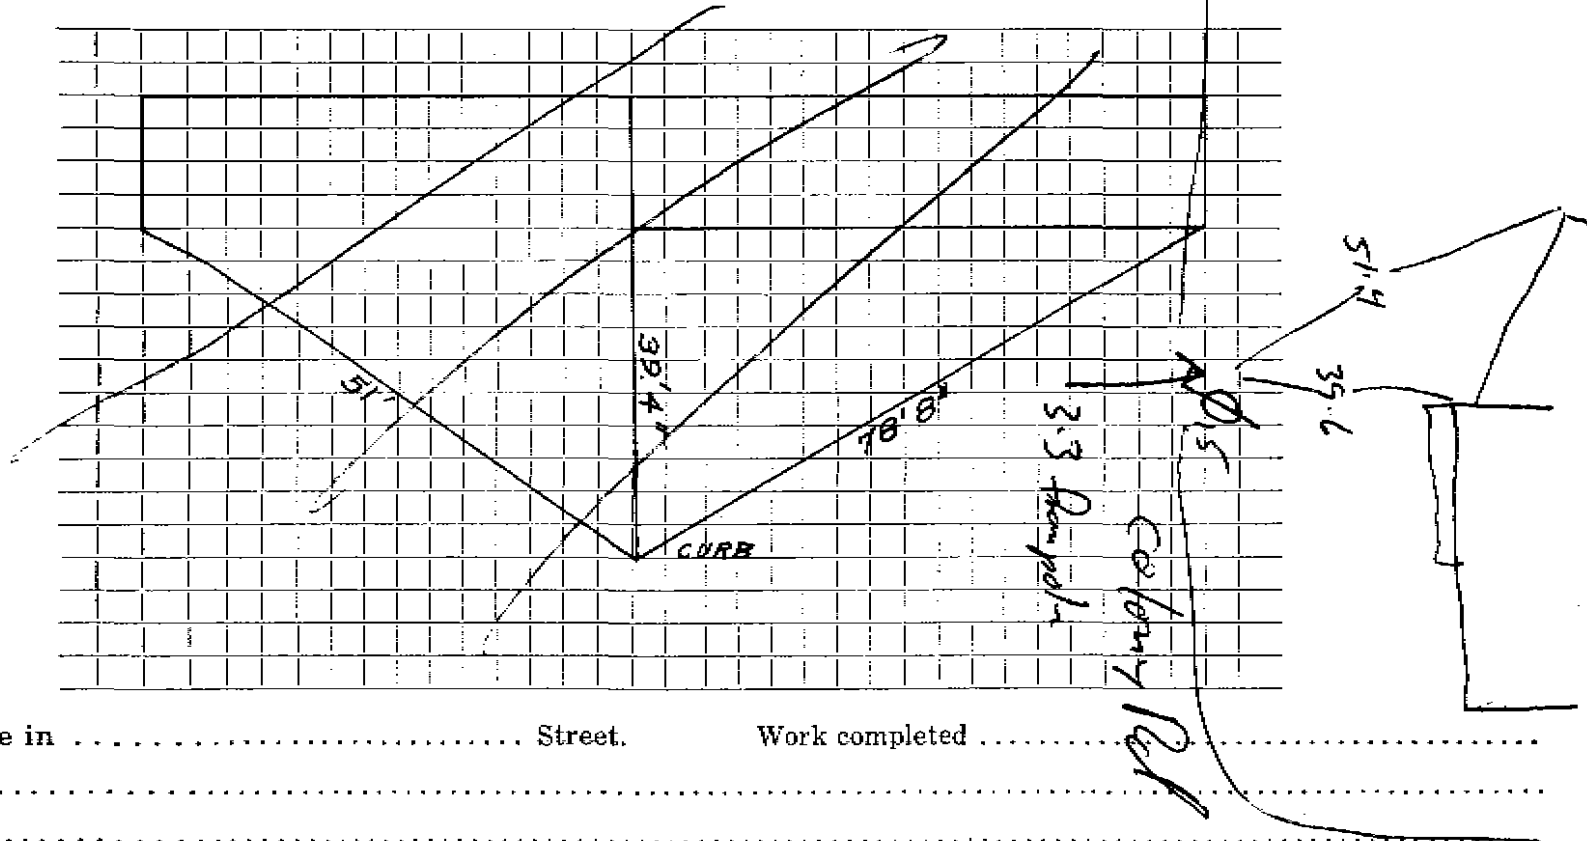

Connection made in Street. Work completed

Remarks:

.....

.....