




DATE \_\_\_\_\_

TOWN OF LEXINGTON — BOARD OF PUBLIC WORKS

**WATER DIVISION**

Sketch of Service Here

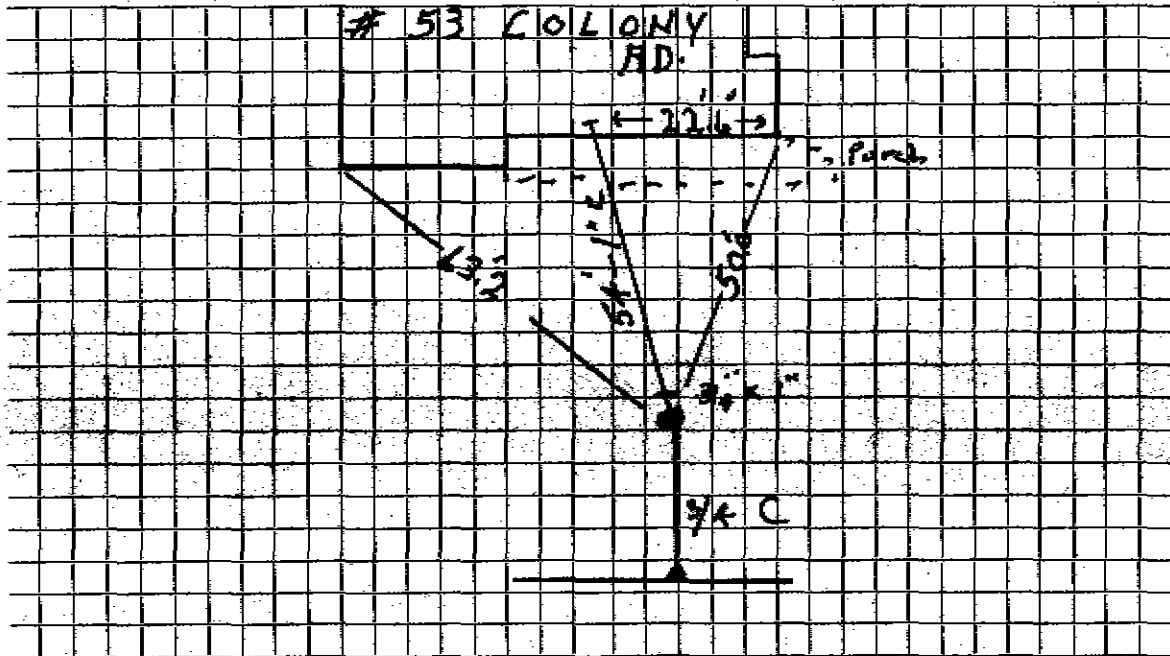

Connection made in..... Street.

Work completed 4/9/09 J. McLaughlin

Remarks:.....  
.....  
.....