

Name William F. Glynn

Service No. 150

Address 54 Colony Road

3485

Lexington, Mass.

Location 54 Colony Road

Kind of Pipe

Size

Size of Main

~~Repair - Renewal~~ - New Service

Com. 9-5-50

Location

Date	Material	Amount	Total	Date	Amount
Jul. 12, '50	Labor	1 30	1 30	June 28 '50	20 00
	10% Overhead		13		
	38' - 3/4" Copper Tubing @.23		8 74		
	1 - 3/4" C x 1/2" I.W.H. S&W		3 29	Jul. 12, '50	3 60
	Trucking 1 hr. @.75		75	8' - 3/4" Copper Tubing @.23	1 84
			14 21	1 - 3/4" C Corp-cock	3 15
				1 - 3/4" C x 3/4" C Curb-cock	3 85
				1 - Box & Rod	3 35
				1 - 1/2" Offset Tail Piece	38
				1 - 1/2" Straight Tail Piece	38
				Littlefield Shovel 2 hrs. @ 7.00	14 00
				Trucking 1 hr. @.75	75
	Labor				31 30

Deposited

No Charge

14 21

DATE _____

TOWN OF LEXINGTON—BOARD OF PUBLIC WORKS

WATER DIVISION

The undersigned applies for a supply of water at No. _____ St. and hereby agrees to comply with the rules and regulations as now, or at any future time, established by the Board of Selectmen.

Am't. of Estimate \$ _____


Owner _____

Am't. Paid \$ _____

Address _____

Builder _____

Sketch of Service Here

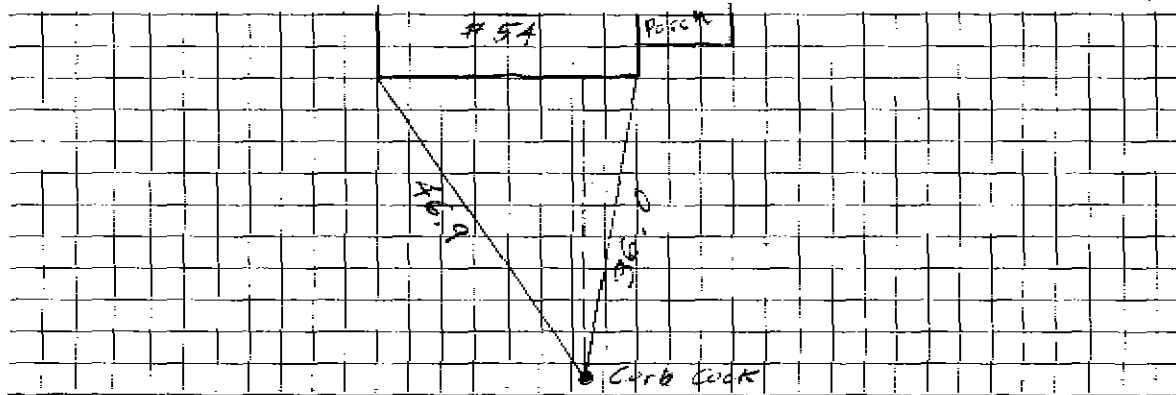

Connection made in _____ Street.

Work completed _____ 19

Remarks: