




DATE \_\_\_\_\_

TOWN OF LEXINGTON — BOARD OF PUBLIC WORKS  
**WATER DIVISION**

Sketch of Service Here

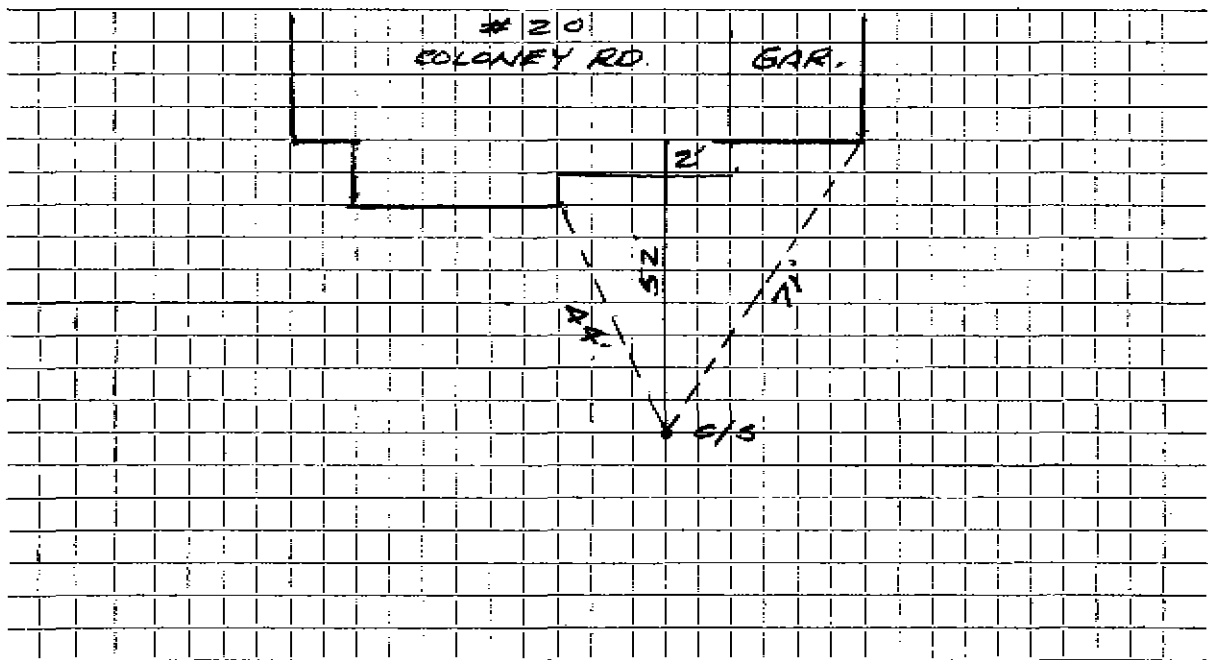

Connection made in COLONEY RD, Street. Work completed .....

Remarks: .....  
.....  
.....