

WATER SERVICE RECORD

#9042

Service No. 52 #8792

Name Sterling Building Corp.

Address 65 Colony Road

4105

Location

~~Rapid-Rampak~~ - New Service

Comm. 9-3-57

Date	Material	Amount	Total	Date	Amount
5/16/57	Labor	1 76		4-1-57	Deposit \$ 50 00
	10% overhead	18	1 94	9-3-57	Refund \$ 18 36
	46' - 3/4" Copper tubing @ .4228	19 45			<u>NON CHARGE</u> \$ 31 64
	1 - 3/4" Cx 1/2 I.W.H. Stop & Waste	4 96		Labor	2 15
	2 - 3/4" C. Unions (3 pt.) @ 2.27	4 54		32' - 3/4" Copper tubing @ .4228	13 53
	1 hr. Trucking		75	1 - 3/4" C. Corp Cock	4 64
			31 64	1 - 3/4" C. Curb Cock	5 94
				1 Box & Rod	4 62
				1 - 1/2 Straight tailpiece	50
				1 - 1/2 Offset tailpiece	50
					31 88


* \$ 731 applied to W.H.C. #54

DATE _____

TOWN OF LEXINGTON — BOARD OF PUBLIC WORKS

WATER DIVISION

Sketch of Service Here

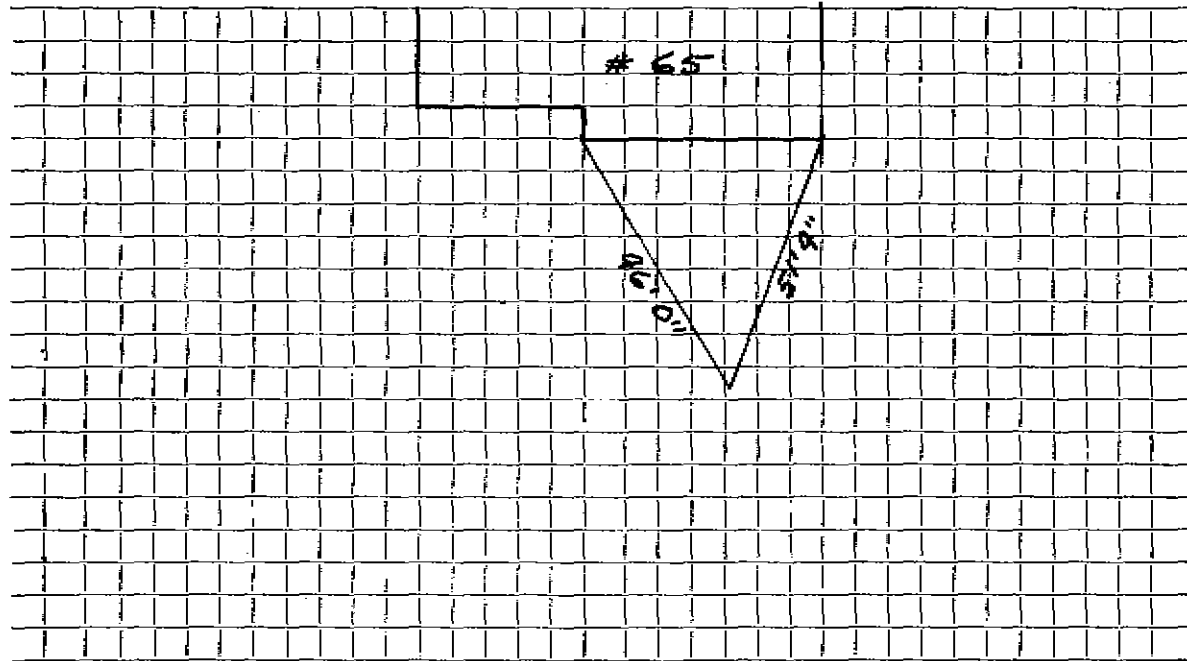

Connection made in Street. Work completed

Remarks:

.....

.....