

WATER SERVICE RECORD

Name Esco Builders Corp.

Service No. 116

Address 68 Colony Road

Location DeFlice Bros. Permit #122


~~Republic~~ - New Service W.O. #9291

FEB 15 1965

Date	Material	Amount	Total	Date	Amount
10-21-64	Labor	4 36		10-24-64	50 00
	10% O.H.	44	4 80	1-15-65	22 03
	5' 3/4" Copper Tubing @.42		2 10		27 97
	1 3/4" Corp Cock		7 41		
	1 3/4" Curb Cock		8 76		
	1 Box & Rod		4 90		
			27 97		
11-2-64	53' 3/4" Copper Tubing				

WATER DIVISION

Sketch of Service Here

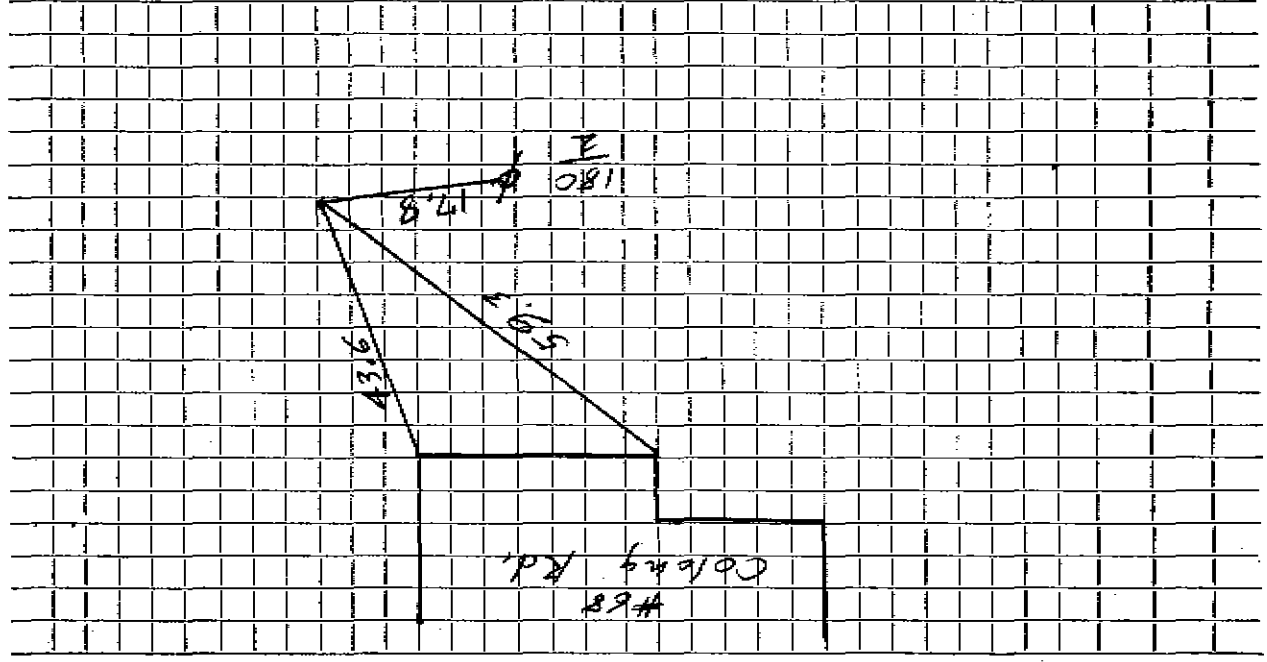

Connection made in _____

Street _____

Work completed _____

Remarks: _____

