

WATER SERVICE RECORD

Name **Stelling Building Corp.**

Service No. 209

Address **70 Colony Road**

Location

Repair ~~Renewal~~ **New Service**

Comm. 12-9-57


| Date | Material | Amount | Total | Date | Amount |
|---------|--------------------------------|--------|-------|---------|------------------|
| 10/2/57 | Labor | 3 52 | | 9-25-57 | 50 00 |
| | 10% overhead | 35 | | 12-2-57 | 22 05 |
| | | | 3 87 | | 27 95 |
| | 49' 3/4" copper tubing @.375 | 18 37 | | | 3 52 |
| | 1 3/4" Cx 1/2 IWH stop & Waste | 4 96 | | | 1 88 |
| | 1 hr. trucking @.75 | 75 | | | 4 64 |
| | | | 27 95 | | 5 94 |
| | | | | | 4 62 |
| | | | | | 50 |
| | | | | | 50 |
| | | | | | 21 60 |

Deposit
Refund
NON CHARGE

DATE _____

TOWN OF LEXINGTON — BOARD OF PUBLIC WORKS
WATER DIVISION

Sketch of Service Here

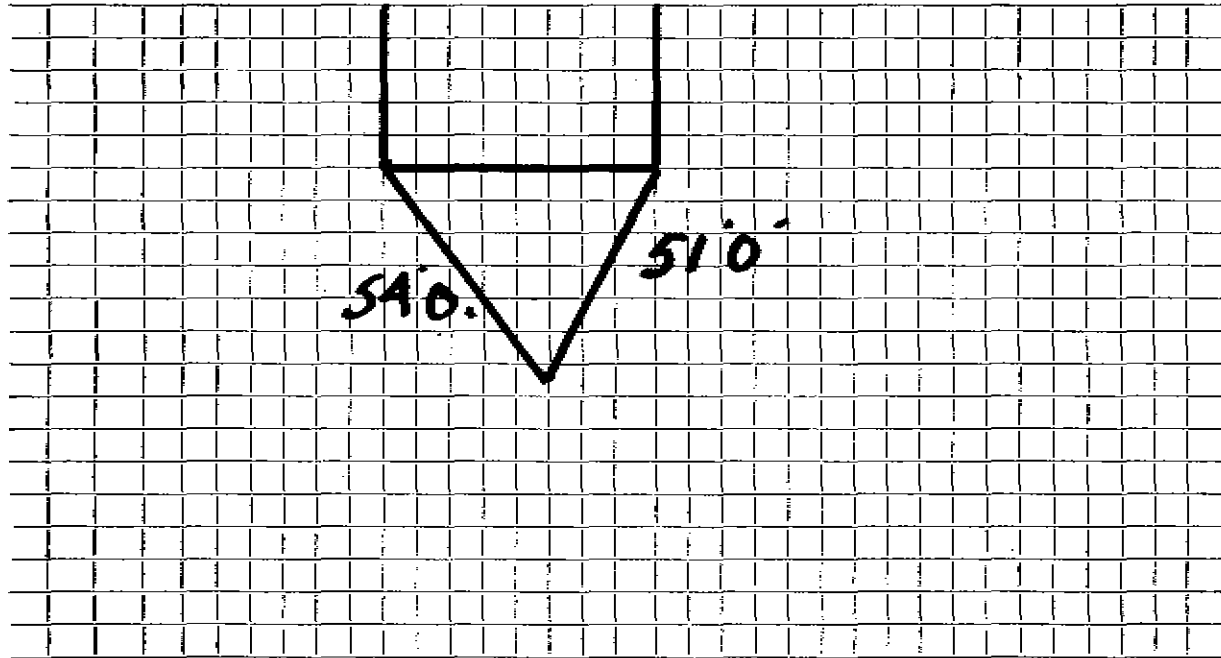

Connection made in Street. Work completed

Remarks:
.....
.....