

WATER SERVICE RECORD

Name Custom Const. Corp.

Service No. 126

Address 9 Colony Road

Location

~~Repair~~ ~~Renewal~~ New Service

Comm 7-6-59


Date	Material	Amount	Total	Date		Amount
6-18-59	Labor	1 85		6-16-59	Deposit	750 00
	10% O. H.	19	2 04	7-6-59	Returned	105 63
51'	3/4" Copper Tubing @.3666		18 70			44 37
1	3/4" C x 1/2 IWH Stop & Waste		5 88		<u>NON CHARGE</u>	
	17 x 3 Patch		17 00	6-18-59	Labor	41 63
1	Hr. Trucking @.75		75	25'	3/4" Copper Tube @.3666	9 17
			44 37	1	3/4" C Corp Cock	4 67
				1	3/4" C Curb Cock	6 07
				1	Box & Rod	5 00
				1	1/2 Straight Tailpiece	50
				1	1/2 Offset Tailpiece	50
				1	Hr. Town Shovel @6.50	6 50
				1	Hr. Trucking	75
						74 79

DATE \_\_\_\_\_

**TOWN OF LEXINGTON — BOARD OF PUBLIC WORKS**

**WATER DIVISION**

Sketch of Service Here

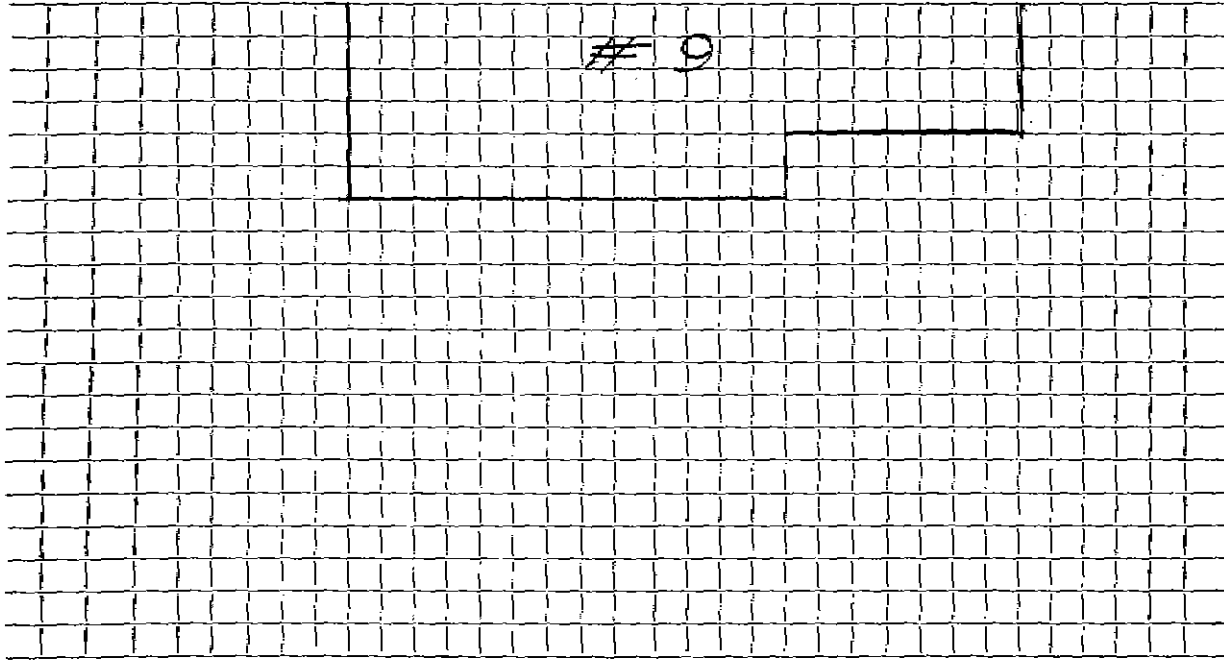

Connection made in ..... Street. Work completed .....

Remarks: .....  
.....  
.....