

WATER SERVICE RECORD

Name Mrs. Rose Ferry

Service No. 161 & 161A

Address 15 Columbus Street

Location Lexington, Mass.


~~Renewal~~ - Renewal - ~~xxxx~~ ~~xxxx~~ Cam - 10-1-51

Date	Material	Amount	Total	Date	Amount	
8-10-51	Labor	4 03	4 03	7-16-51 8-2-51	Deposited " "	32 00 4 00
	10% Overhead		40	11-1-51	Refunded	2 70
	28' - 3/4" Copper Tubing @ .326		9 12			03 20
	1-3/4" C x 1/2 I.W.H. S&W		4 00		No Charge	
	2 Hr. Littlefield Shovel &	7.00	14 00	8-10-51	Labor	7 01
	1 Hr. Trucking		75		28'-3/4" Copper Tubing @ .326	9 12
			32 30		1-3/4" C. Corp-Cock	4 33
					1-3/4" C x 3/4" C. Curb Cock	4 67
					1- Box & Hod	4 68
					1-1/2 Offset Tail Piece	50
					1-1/2 Straight Tail Piece	50
					2 Hrs. Littlefield Shovel @ 7.00	14 00
					1 Hr. Trucking @ .75	75
						<u>45 56</u>

DATE \_\_\_\_\_

**TOWN OF LEXINGTON — BOARD OF PUBLIC WORKS**  
**WATER DIVISION**

Sketch of Service Here

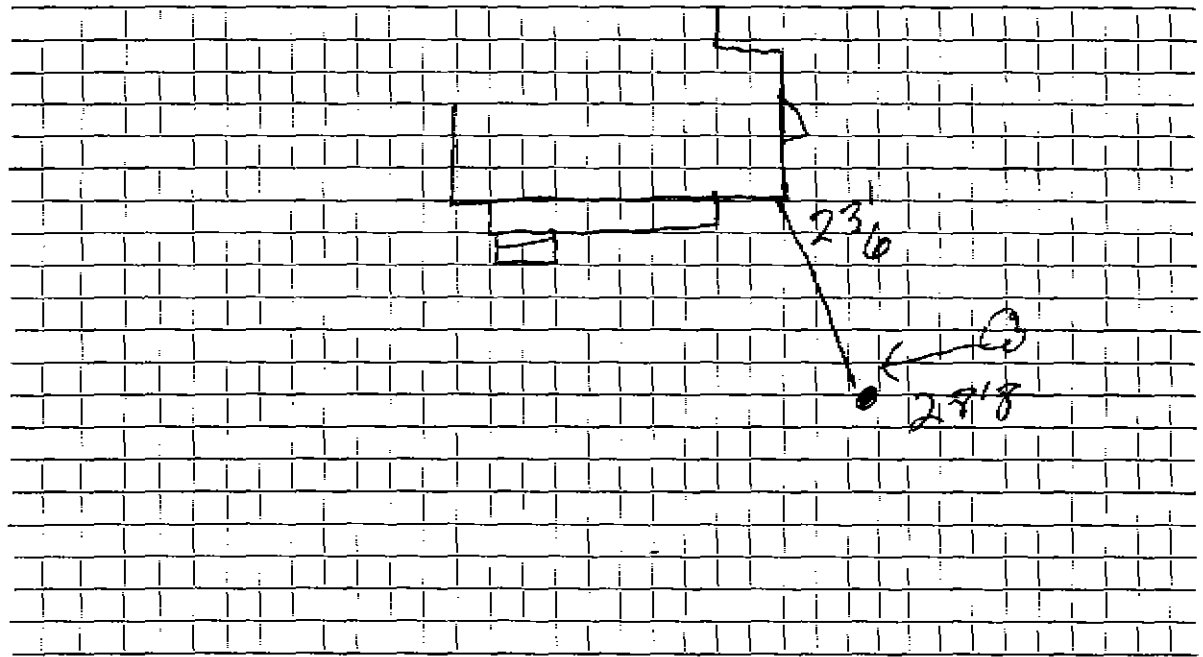

Connection made in ..... Street. Work completed .....

Remarks: .....  
.....  
.....