

3575

John James Phinney
~~Erwin Mitchell~~

WATER SERVICE RECORD

Service No. 133

Address 17 Columbus Street

2244

Location Lexington

6630

~~RENEWAL~~ - Renewal - ~~RENEWAL~~


am. 9-22-52

Date	Material	Amount	Total	Date	Amount
8/20/52	Labor	5 80		7-10-52	Deposited 25 00
8/21/52	"	5 00	10 80	9-22-52	Refunded 1 05
	10% overhead		1 08	6/2/65	NON CHARGE
	30' - 3/4" copper tubing @ .3439		10 32	8/21/52	Labor 25 33
	1 - 3/4" C x 1/2 I.W.H. stop & waste	4 00		19' - 3/4" copper tubing @ .3439	3 44
	1 hr. Littlefield shovel	7 00		1 - 3/4" C. corp-cock	4 33
	1 hr. trucking		75	1 - 3/4" C x 3/4" C. curb-cock	4 67
			33 95	1 box and rod	3 90
				1 - 1/2 offset tail piece	50
				1 - 1/2 straight tail piece	50
				1 hr. Littlefield shovel	7 00
				1 hr. trucking	75
					50 42

TOWN OF LEXINGTON — BOARD OF PUBLIC WORKS

WATER DIVISION

Sketch of Service Here

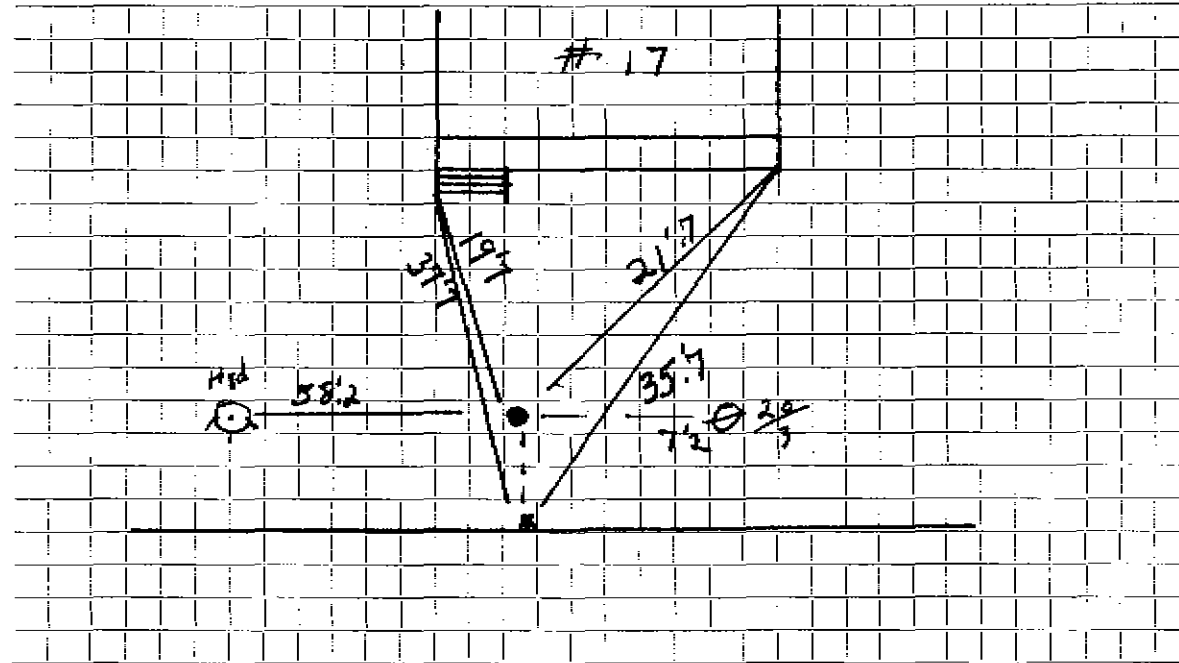

Connection made in Street. Work completed

Remarks:

.....

.....