

WATER SERVICE RECORD

Name Brothers Trust

Service No. 8

Address 22 Columbus Street

#57393

Location

Repair—Renewal—New Service change water service to main DeFlice Bros. permit #1844 4/6 AUG 14 1972


Date	Material	Amount	Total	Date	Amount
6-1-65	Labor	33 67		4-26-71	69 59
	10% O.H.	3 37		Deposit	
		37 04	37 04		
	19'-3/4" copper tubing @.42		7 98		
	1 - Cooperation		7 41		
	1 - Curb		8 76		
	1 - Box & Road		4 90		
	1/3 Hr. Town Shovel @6.50		2 17		
	1/3 Hr. Loader @ 4.00		1 33		
			69 59		

DATE _____

TOWN OF LEXINGTON — BOARD OF PUBLIC WORKS

WATER DIVISION

Sketch of Service Here

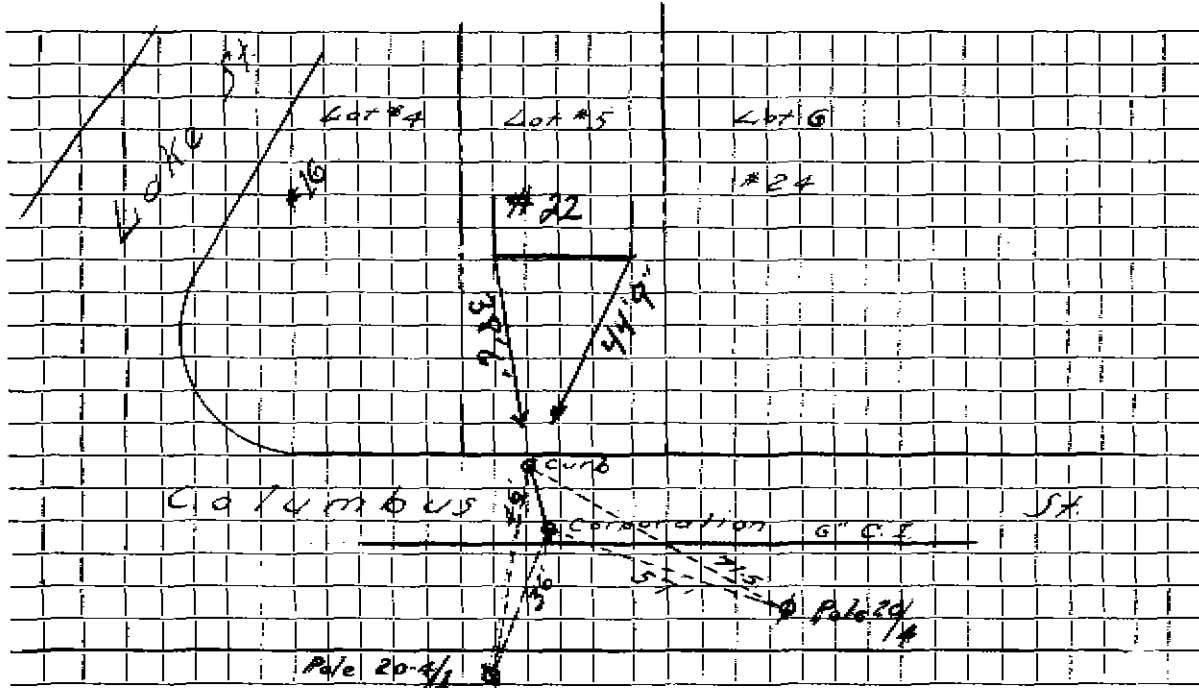

Connection made in _____ Street. Work completed _____

Remarks: _____

