

WATER SERVICE RECORD

Name Harold Asp

Service No.

Address 23 Columbus Street

Location

Repair—Renewal—New Service Change water service to main


| Date | Material | Amount | Total | Date | Material | Amount |
|---------|----------------------------|--------|-------|---------|------------|--------|
| 6-3-65 | Labor | 43 29 | | | | |
| | 10% O.H. | 4 33 | 47 62 | 3/29/52 | | |
| | 8'-3/4" Copper tubing @.42 | | 3 36 | 15' | 3/4 COPPER | |
| | 1 Corporation | | 7 41 | | 3/4 CORP | |
| | 1 Union | | 2 08 | | 3/4 Coub | |
| | 1 Hr. Town Shovel | | 6 50 | | Box a Rod | |
| | 1 Hr. Loader | | 4 00 | | | |
| | | | 70 97 | | | |
| 3/29/52 | 45' 3/4 COPPER | | | | | |
| | 1 3/4 x 1/2 S & W | | | | | |

DATE _____

TOWN OF LEXINGTON — BOARD OF PUBLIC WORKS

WATER DIVISION

Sketch of Service Here

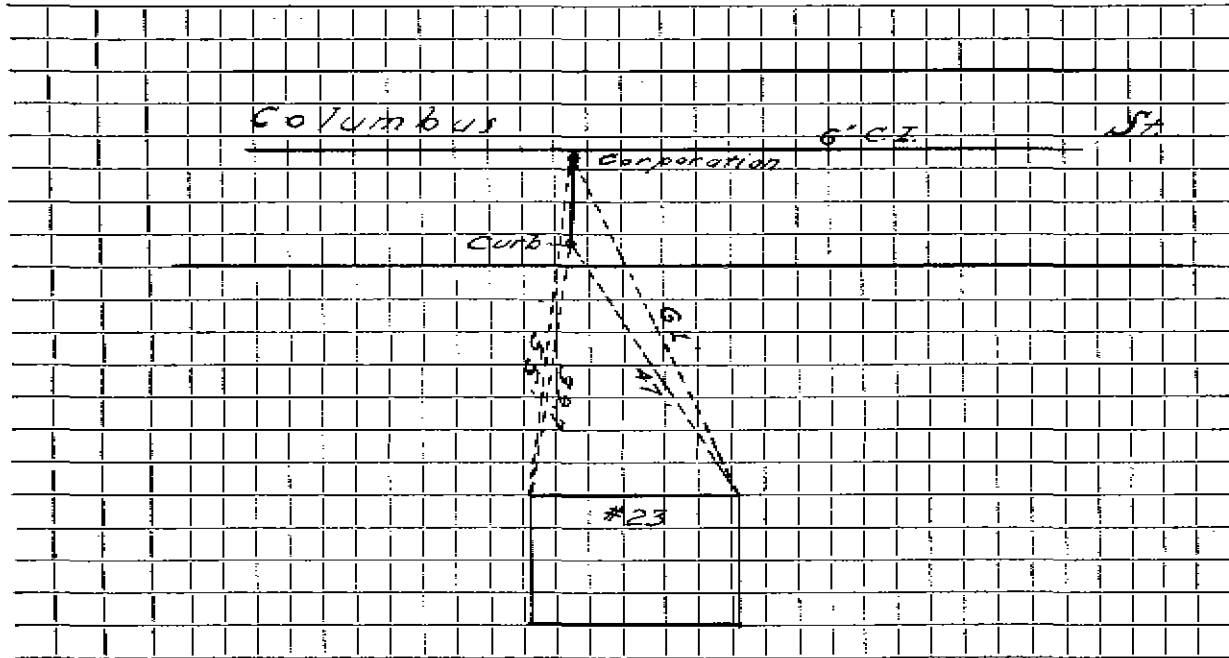

Connection made in _____ Street. Work completed _____

Remarks: _____
