

WATER SERVICE RECORD

Name Harold Asp

Service No.

Address 25 Columbus Street

Location

Repair—Renewal—New Service Change water service to main


Date	Material	Amount	Total	Date	Amount
6-2-65	Labor	43 29			
	10% O.H.	4 33	47 62	2/8/52	
	8' 3/4" copper tubing @ .42		3 36	20' 3/4 Copper	
	1 Corporation		7 41	3/4 CORP	
	1 Union		2 08	3/4 Curb Cock	
	1/3 Hr. Town Shovel @ 6.50		2 17	Box + Rod	
	1/3 Hr. Town Loader @ 4.00		1 33		
			63 97		
2/8/52	40' 3/4 COPPER 3/4 x 1/2 S+W				

DATE _____

TOWN OF LEXINGTON — BOARD OF PUBLIC WORKS

WATER DIVISION

Sketch of Service Here

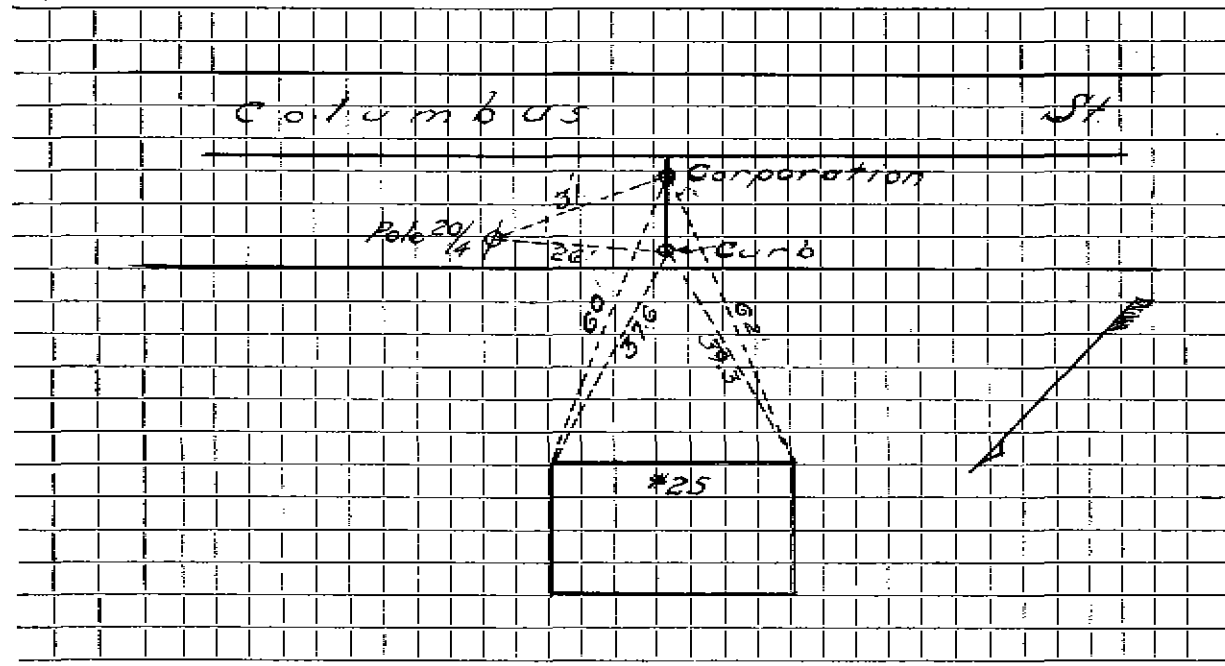

Connection made in _____ Street. Work completed _____

Remarks: _____

