
₩.F.W.15010		WATE	e servici	F RECORD			
Name Busa R	WATER SERVICE RECORD Busa Realty					Service No.	
Address 30		mbus .	SE.				
Location			<u> </u>			<u></u>	
Repair—Renewal—New Service DeFelice #3132							
Date	Material	Amount	Total	Date		Amoun	
4/73 104 3/4"	Corpor tubis	-				- <u>-</u>	
1447 - 157 styl 7 f. sty -	cobie: com	- 6					
			· ·				
	· -			-			
·		" 		 		†·	
						ļ	
					<u></u>		
		-					
			<u> </u>	<u> </u>			
			!	<u> </u>			
				·			
		:	<u> </u>				
: : 							
-							
		-					
· · ·				1			
			•	1			

DATE		

TOWN OF LEXINGTON - BOARD OF PUBLIC WORKS

WATER DIVISION

Sketch of Service Here

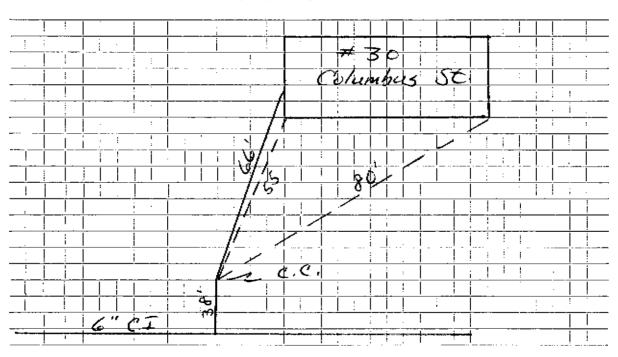

Connection made in Street.	Work completed
Remarks:	