

WATER SERVICE RECORD

Name Murray MacMillan

Service No.

3030
#5992

Address 31 Columbus Street

#7189

Location

Repair ~~General Water Service~~ W.O. #249 & 360


Date	Material	Amount	Total	Date	Material	Amount	Total
	<u>BROKEN WATER SERVICE</u>				<u>CHANGE OVER WATER SERVICE</u>		
5-6-65	Labor	3 05		6-24-65	Labor	49.86	
	10% O.H.	31	3 36		10% O.H.	4.99	54 85
6'	3/4" copper tubing @ .42		2 52	Outside 20'	3/4" copper tubing @ .42		8 40
1	1" style 38 dresser sleeve			Inside 15'	3/4" copper tubing @ .42		6 30
1	3/4" 2 part union		2 08	1	Corp.		7 41
1	1" lead line coupling		74	1	Curb		8 76
1	1" E.L. Nipple		65	1	Box & Rod		4 90
				1	Repair clamp 1"-#38		2 26
				1	1 x 5 CL Nipple		74
				1	1 x 3/4- 2 part Union		2 08
				2	Hrs. Shovel @ 6.50		13 00
				1	Hr. Truck		3 00

DATE _____

TOWN OF LEXINGTON — BOARD OF PUBLIC WORKS

WATER DIVISION

Sketch of Service Here

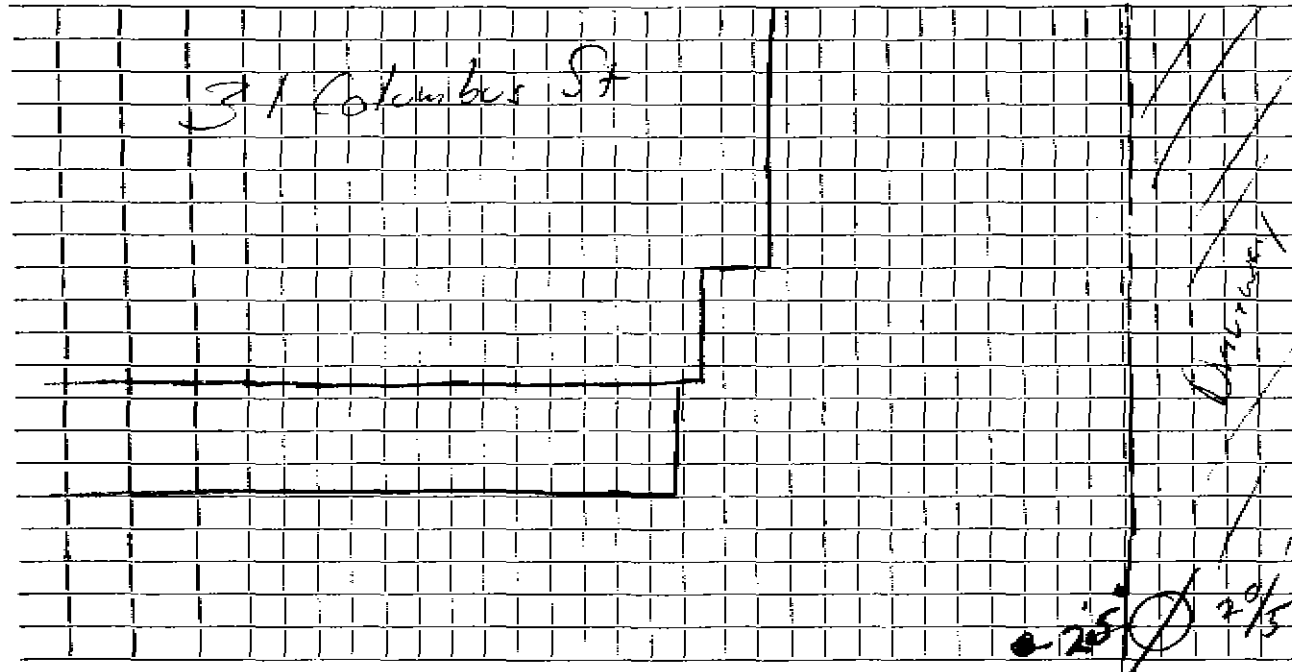

Connection made in Street. Work completed

Remarks:
.....
.....