
	F.3.X.1601c				WATER SERVICE RECORD													
Name			77.20 22000										Service No.					
	Addr	ess	33	$\overline{C}$	Yolu	mb	45	<del>-</del> 57.		_			<del></del> _					
	Locat																	
	Repai	ir—R	enewal-	-New	Servi	ce (	De Fli	ee î	Bres.	# 313	33							
<del></del>	Date		Material		Amount			Total		Date					Amount			
==	<u> </u>		_==_:	====		===	<del> </del>	<del></del>								‡= <del>=</del> =		<del></del>
10-5		73	28'-	3/4"	Cop	per		- <del> </del>		<del>-    </del>		<del> </del>			<u>-</u> -			
							<b>_</b>											
									<b>-</b>			· · · · · · · · · · · · · · · · · · ·						
	i	i					İ	_ <u> </u>					<del>_</del>	<del></del>		<u> </u>		
							! 	'	<b>⊢</b> -—-	! <del>-</del>	<b>-</b>	! —				<u> </u>		<u>-</u> _
	<u> </u>	i					Ĺ <u>.</u>				<u> </u>					ļ		
	!						- <del></del>		· 		· 	· · <del> ·  </del> -				<u> </u>		
	— <u>—</u>	<u> </u>					<del> </del>	<del></del>	<u> </u>			$\perp$				<del> </del>		
		<u></u> -			<del>_</del>	<del></del>	! 		 		<del>-</del> — –	<del></del>	·			<u> </u>	<u> </u>	
—			<del></del> -				<del> </del> -	<del></del> _	· 	-		<u> </u>		<del></del> .	<del></del>	<del> </del>		
		! 					 	-	! =_ <del></del> _	<u>:</u> — –	<del></del>	· 				<u> </u>		
	<del>-</del>					- <del></del>	<del>-</del>	†	<del></del>	<del>     </del>	ļ. ——	<del>,                                    </del>				<del></del>	ļ	
<del>_</del> _			<del></del>			<del></del>	ļ <b>-</b> -	+	<u> </u>	<u> </u>	<del></del>	<u> </u>	<del></del>	<del></del>	<del></del> -	<del> </del>		
<del>-</del>						- <del>-</del>			<u>-</u>	·	<del> </del>	<del></del>		_ <del></del>	<del></del>		:	
<del></del>							ļ	. — <del> :</del>	<u> </u>		<del>-</del>	<u>-</u>   -	_ <del>_</del>	<del></del>	- <del>_</del>	<del></del>		
<del>_</del> _				·				+	_ <del></del> _			<u> </u>	<del></del>		<del></del>	<del> </del>	- <del>-</del> -	
	<u> </u>			-· ·— <del>-</del>			- ——— i		<del>,</del> i		<del> </del>	<del></del>			<del></del>			
			-						1	. !	'						- :	

	· ·
DATE	

## TOWN OF LEXINGTON - BOARD OF PUBLIC WORKS

## WATER DIVISION

## Sketch of Service Here

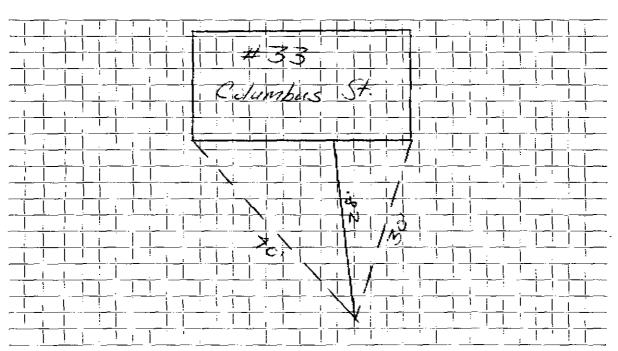

Connection made in	Street.	Work completed	* * * * * * * * * * * * * * * * * * * *	
			•	
Remarks:				

.....