

Name Jesse Curra

Service No. 58 3157

Address 5 Columbus Street

Lexington, Mass.

Location 5 Columbus Street

Kind of Pipe

Size

Size of Main

~~Repair—Renewal—New Service~~

Location

Date

Material

Amount

Total

Date

Amount

July 13, '46

Labor

90

90

July 11, '46

Reported

15 00

10% Overhead

99

58' - 1/2" Copper Tubing @ .1911

11 08

Non-Charge

1-1/2" C x 1/2" I.W.E. Stop &amp; Waste

2 82

July 11, '46

Labor

4 50

Trucking 1 hr. @ .75

75

July 13, '46

"

13 90

15 64

Trench Dug By Owner

20' - 1/2" Copper Tubing @ .1911

3 82

1-1/2" C Carb-cock

2 70

1-1/2" C x 1/2" C Carb-cock

3 50

1 - Box &amp; Rod

1 65

1-1/2" Offset Tail Piece

90

1-1/2" Straight Tail Piece

90

Trucking 1 hr. @ .75

75

Labor

37 42

DATE \_\_\_\_\_

# TOWN OF LEXINGTON—BOARD OF PUBLIC WORKS

## WATER DIVISION

The undersigned applies for a supply of water at No. \_\_\_\_\_ St. and hereby agrees to comply with the rules and regulations as now, or at any future time, established by the Board of Selectmen.


Am't. of Estimate \$ \_\_\_\_\_

Owner \_\_\_\_\_

Am't. Paid \$ \_\_\_\_\_

Address \_\_\_\_\_

Builder \_\_\_\_\_

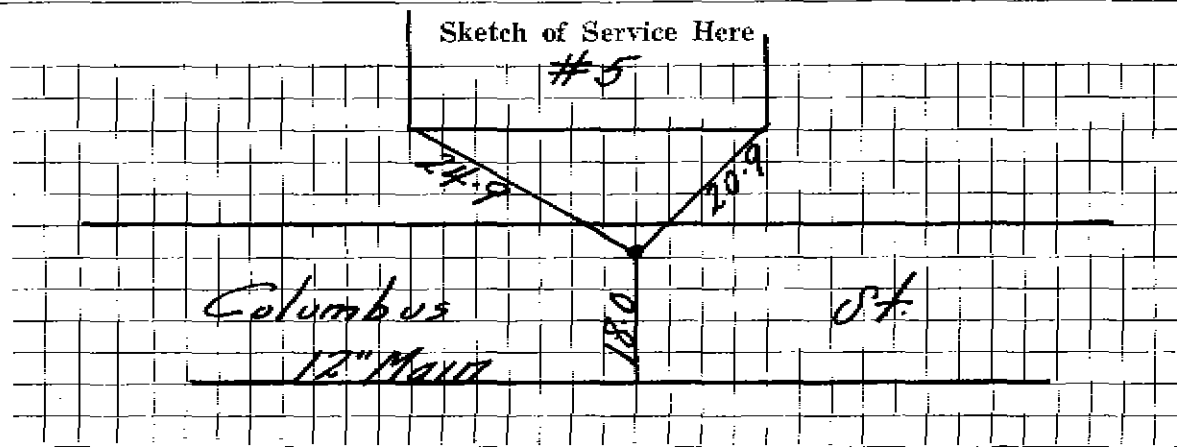

Connection made in \_\_\_\_\_ Street.

Work completed \_\_\_\_\_ 19

Remarks: