

WATER SERVICE RECORD

Name Louis Bentley Jr.

Service No. 73

Address 8 Columbus Street

695

Location

~~Water Service~~ - New Service

W.O. #8094

Comm 10-28-63


| Date | Material | Amount | Total | Date | Amount | |
|---------|---------------------------------|--------|-------|----------|----------------------------|--------|
| 8-13-63 | Labor | 10 14 | | 8-2-63 | Deposit | 100 00 |
| | 10% O.H. | 1 01 | 11 15 | 10-28-63 | Refund | 50 61 |
| | 46' 3/4" Copper Tubing @ .42 | .42 | 19 32 | | | 49 39 |
| | 1 3/4" C x 1/2 IWH Stop & Waste | 6 17 | 6 17 | | NON CHARGE | |
| | 1 1/2 hr. Town Shovel @ 6.50 | 9 75 | 9 75 | | Labor | 3 94 |
| | 1 hr. Trucking @ 3.00 | 3 00 | 3 00 | | 13' 3/4" Cop. Tubing @ .42 | 5 46 |
| | | | 49 39 | | 1 3/4" Corp. Cock | 4 91 |
| | | | | | 1 3/4" Curb Cock | 6 28 |
| | | | | | 1 Box & Rod | 4 90 |
| | | | | | 1 hr. Town Shovel @ 6.50 | 6 50 |
| | | | | | | 31 99 |

DATE _____

TOWN OF LEXINGTON — BOARD OF PUBLIC WORKS

WATER DIVISION

Sketch of Service Here

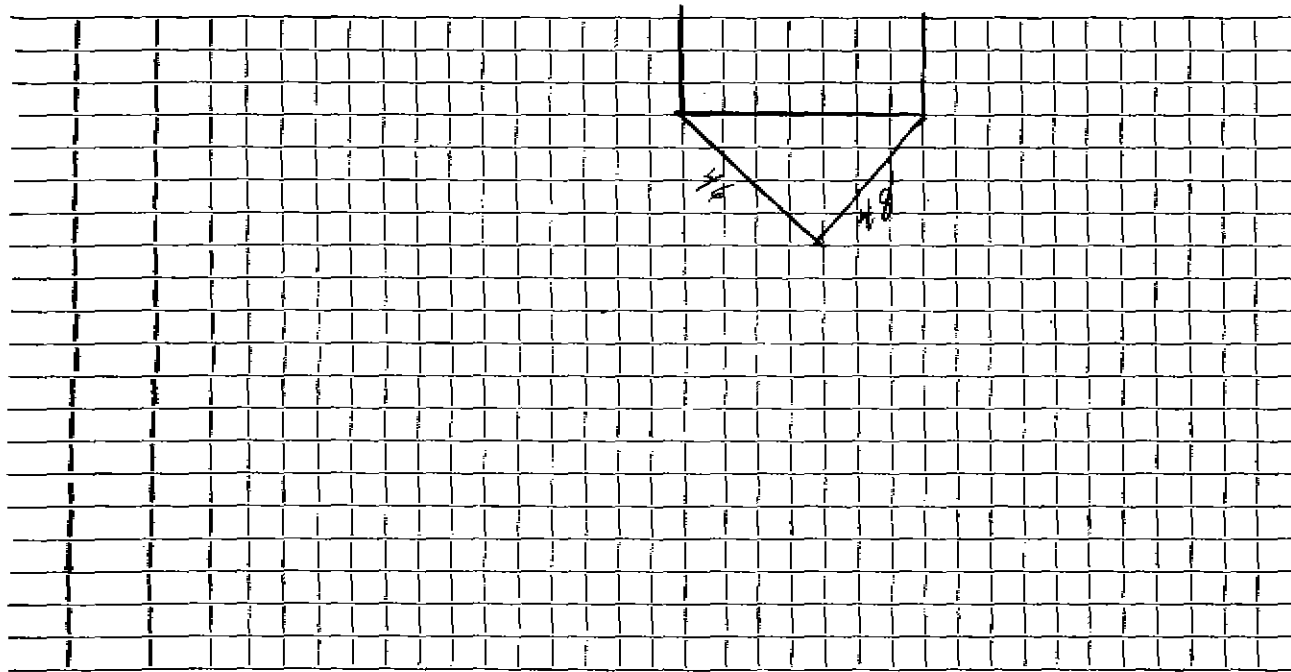

Connection made in _____ Street. Work completed _____

Remarks: _____

