





DATE 10-19-20

TOWN OF LEXINGTON — BOARD OF PUBLIC WORKS

WATER DIVISION

Sketch of Service Here

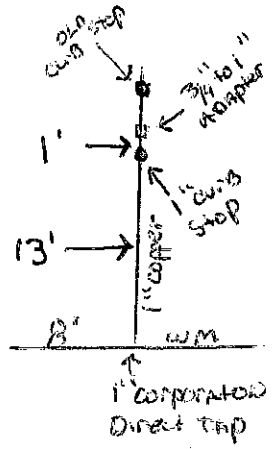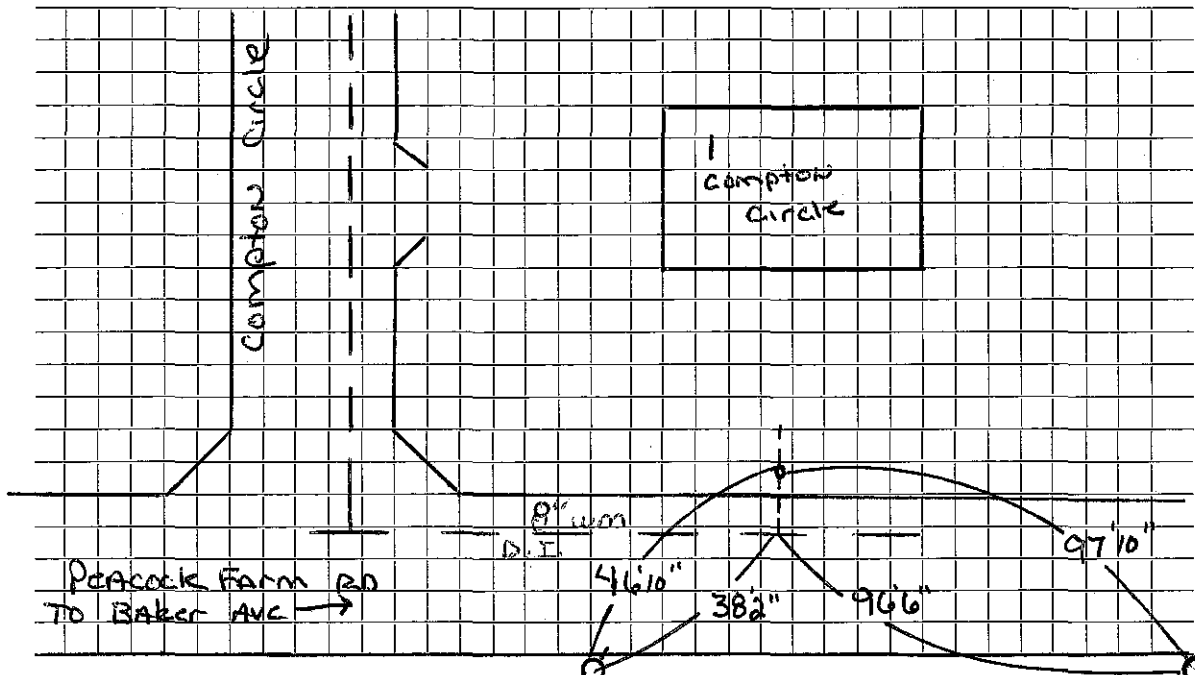

Connection made in ..... Street. Pole 23 Work completed ..... Pole 24

Remarks: Due to location of old curb stop it was left in place. Installed new main to curb stop