

WATER SERVICE RECORD

Name Benjamin Franklin Homes Service No. 244

Address 4 Compton Circle, Lexington, Mass. # 7042

Location _____


~~Repair/Replacement~~ New Service *Comm. 12-9-57*

Date	Material	Amount	Total	Date	Amount
10-24-57	Labor	3 27		10-22-57 Deposit	40 00
	10% overhead	33		12-2-57 Refund	11 19
		<u>3 60</u>	3 60		<u>28 81</u>
	52'-3/4" Copper tubing @.375	19 50			NON CHARGE
	1-3/4" C x 1/2 IWB stop & waste	4 96		10-24-57 Labor	3 28
	1 hr. Trucking @.75		75	26'-3/4" Copper tubing @.375	9 75
			<u>28 81</u>	1-3/4" C Comp Cock	4 64
				1-3/4" C Curb Cock	5 94
				1 Box & Rod	4 62
				1-1/2 straight tailpiece	50
				1-1/2 offset tailpiece	50
					<u>29 23</u>

TOWN OF LEXINGTON — BOARD OF PUBLIC WORKS

WATER DIVISION

Sketch of Service Here

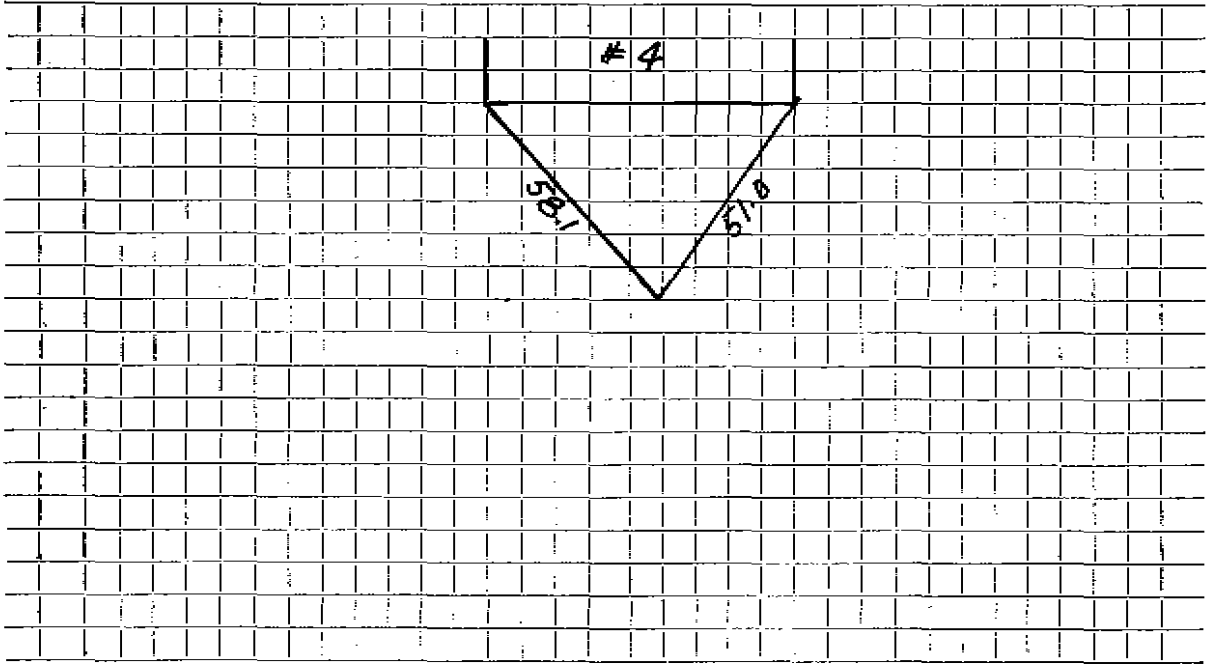

Connection made in Street. Work completed

Remarks:
.....
.....