

WATER SERVICE RECORD

Name Benjamin Franklin Homes

Service No. 245

Address 5 Compton Circle, Lexington, Mass.

5702

Location

~~Repair - Renewal~~ - New Service

Comm. 12-9-57


Date	Material	Amount	Total	Date	Amount
10-24-57	Labor	3 27		10-22-57	Deposit 40 00
	10% Overhead	33	3 60	12-2-57	Pd. by refund on W. H. C. #243 1 58
	10'-3/4" Copper tubing @.375	30 00			# 41 58
	1-3/4" C x 1/2 IWH stop & waste	4 96			NON CHARGE
	1 hr. Trucking @.75		75	10-24-57	Labor 3 28
	1-3/4" C x 3/4"-3 part union	2 27	41 58	16'-3/4" Copper Tubing @.375	6 00
				1-3/4" C Corp Cock	4 64
				1-3/4" C Curb Cock	5 94
				1 Box & Rod	4 62
				1-1/2 straight tail piece	50
				1-1/2 offset tail piece	50
					25 48

TOWN OF LEXINGTON — BOARD OF PUBLIC WORKS

WATER DIVISION

Sketch of Service Here

W.S. For # 5

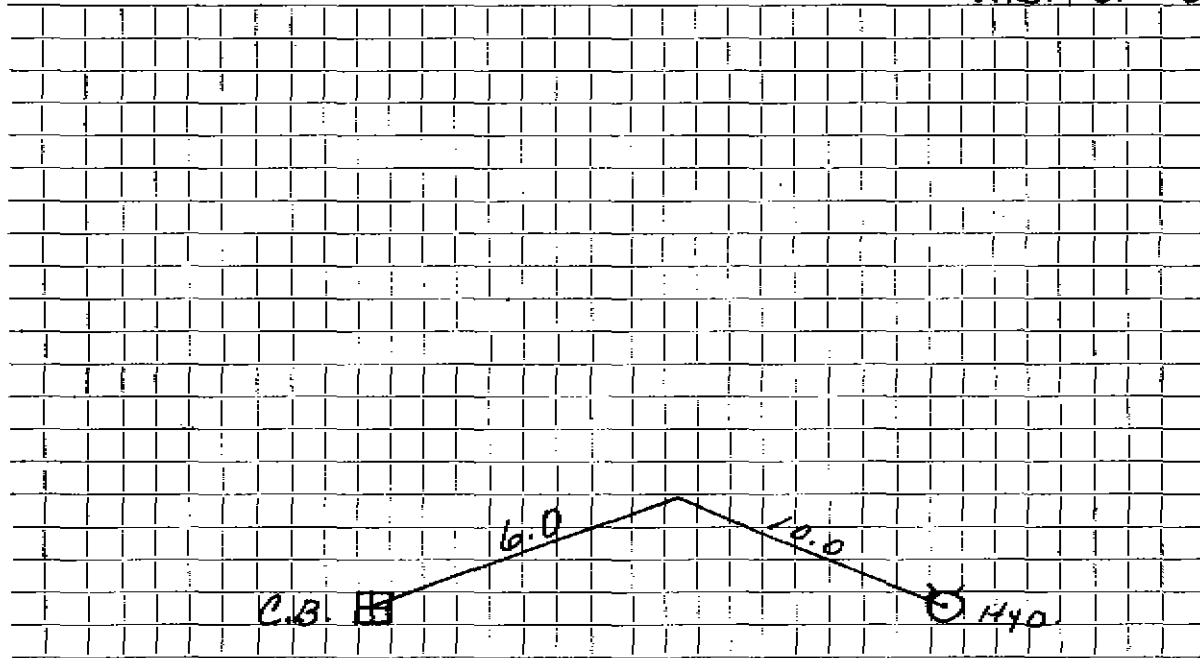

Connection made in Street. Work completed

Remarks:

.....

.....