

WATER SERVICE RECORD

Name Benjamin Franklin Homes
 Address 6 Compton Circle, Lexington, Mass.
 Location

Service No.

4910
 # 4911
 246


~~Repair/Resort~~ - New Service

Date	Material	Amount	Total	Date	Amount
11-24-57	Labor	3 27		10-22-57	Deposit 40 00
	10% overhead	33	3 60	12-2-57	Pd. by refund on 2. HC #247 2 33
	82'-3/4" Copper tubing @.375		30 75		\$ 42 33
	1-3/4" C x 1/2" IWH stop & waste		4 96		NON CHARGE
	1 hr. Trucking @.75		75	11-24-57	Labor 3 28
	1-3/4" C x 3/4" C-3 part union		2 27	57'-3/4" Copper tubing @.375	21 38
			42 33	1-3/4" C Corp Cock	4 64
				1-3/4" C Curb Cock	5 94
				1 Box & Rod	4 62
				1-1/2 straight tail piece	50
				1-1/2 offset tail piece	50
					40 86

DATE _____

TOWN OF LEXINGTON — BOARD OF PUBLIC WORKS
WATER DIVISION

Sketch of Service Here

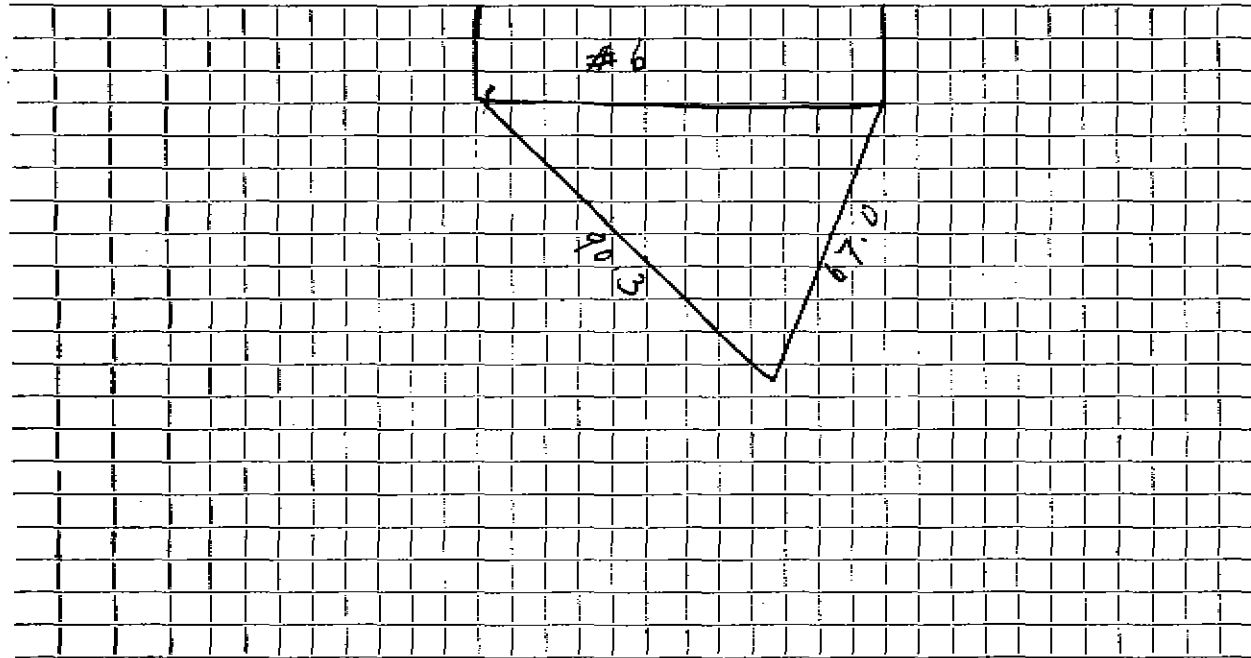

Connection made in Street. Work completed

Remarks:
.....
.....