

WATER SERVICE RECORD

Name

Service No.

Address

100 CONCORD AVE


Location

Repair—Renewal—New Service

Date	Material	Amount	Total	Date	Material	Amount
4/25/62	21' 3/4 COPPER			4/25/62	31' 3/4 COPPER	
	1 3/4 x 1/2 S + W				1 3/4 CURB STOP	
	1 3/4 PART UNION				BOX ROD	
8-18-97	Repair			1982	NEW MAIN	
	5' 3/4" COPPER				1 3/4 COPR	
	2 3/4" x 3/4" C 3 PART UNIONS					

TOWN OF LEXINGTON — BOARD OF PUBLIC WORKS  
**WATER DIVISION**

Sketch of Service Here

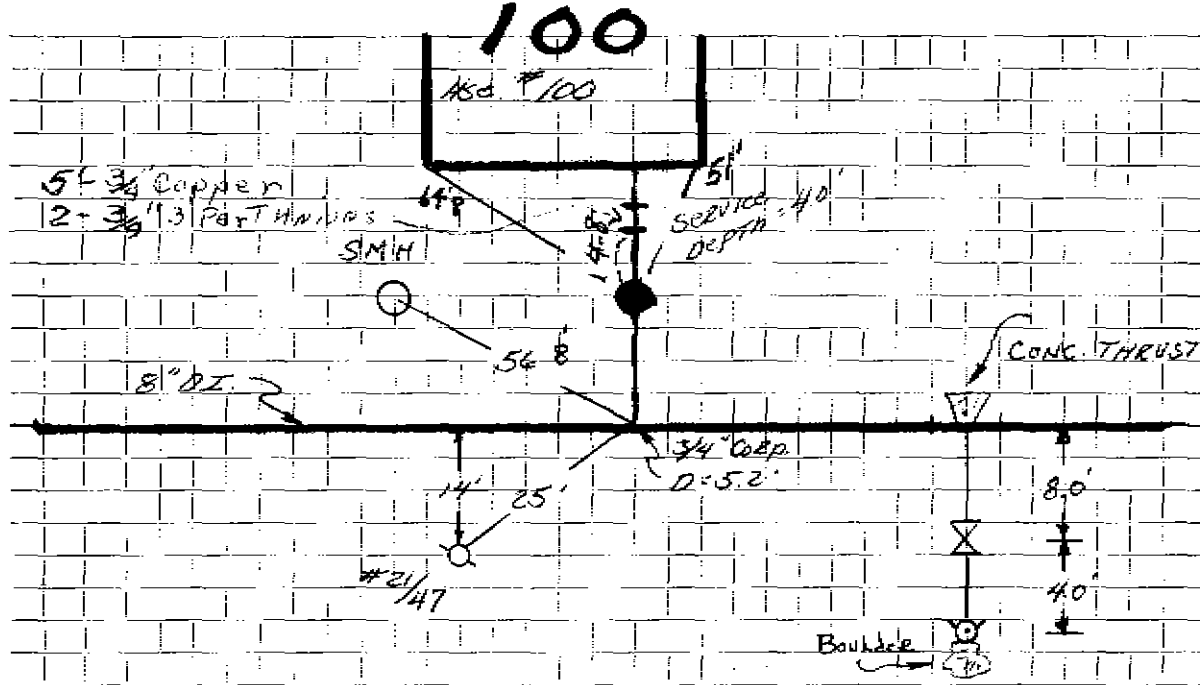

Connection made in CONCORD AVE Street. Work completed .....

Remarks: CONTRACT 82-3-E - Sewer line crosses water service where repair was made 8-18-97