




DATE \_\_\_\_\_

TOWN OF LEXINGTON — BOARD OF PUBLIC WORKS  
WATER DIVISION

Sketch of Service Here

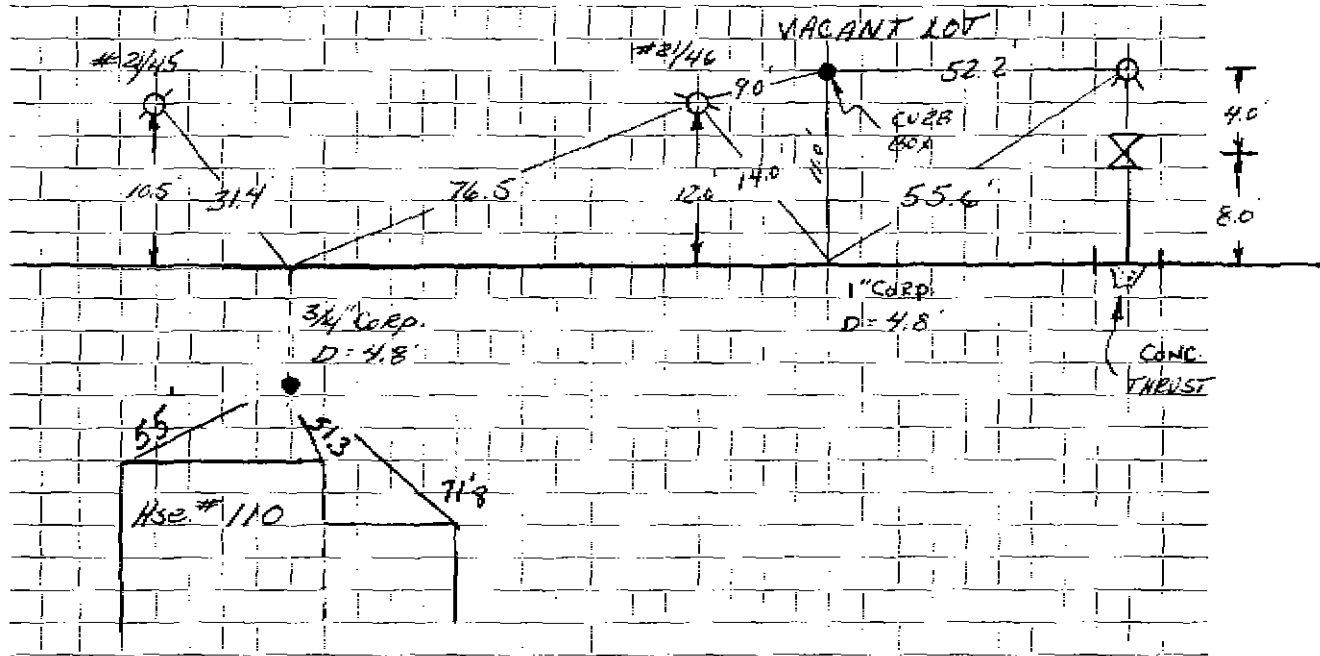

Connection made in CONCORD AVE. Street. Work completed .....

Remarks: CONTRACT 82-3-E .....