

6324 # 6067

WATER SERVICE RECORD

Name Gus Mici

Service No. 45

Address 110 Concord Avenue

7114

Location

~~Renewal~~ New Service DeFlice Bros. Permit #302 - W.O. #351


OCT 25 1965

Date	Material	Amount	Total	Date	Amount	
6-4-65	Labor	31.17		5-25-65	Deposit	150 00
6-7-65	Labor	35.07	66 24	11-25-65	Retund	9 81
	10% O.H.	6 62	72 86			140 19
28'	3/4" Copper Tubing @ .42		11 76			
	25 X 3 Patch		25 00			
1	Curb		8 76	1972	NEW MAIN	
1	Corp.		7 41	1	3/4 CORP	
1	Box & Rod		4 90			
1	Hr. Town Truck		3 00			
1	Hr. Town Tractor		6 50			
			140 19			
7-16-65	49' 3/4" Copper tubing					

DATE _____

TOWN OF LEXINGTON — BOARD OF PUBLIC WORKS
WATER DIVISION

Sketch of Service Here

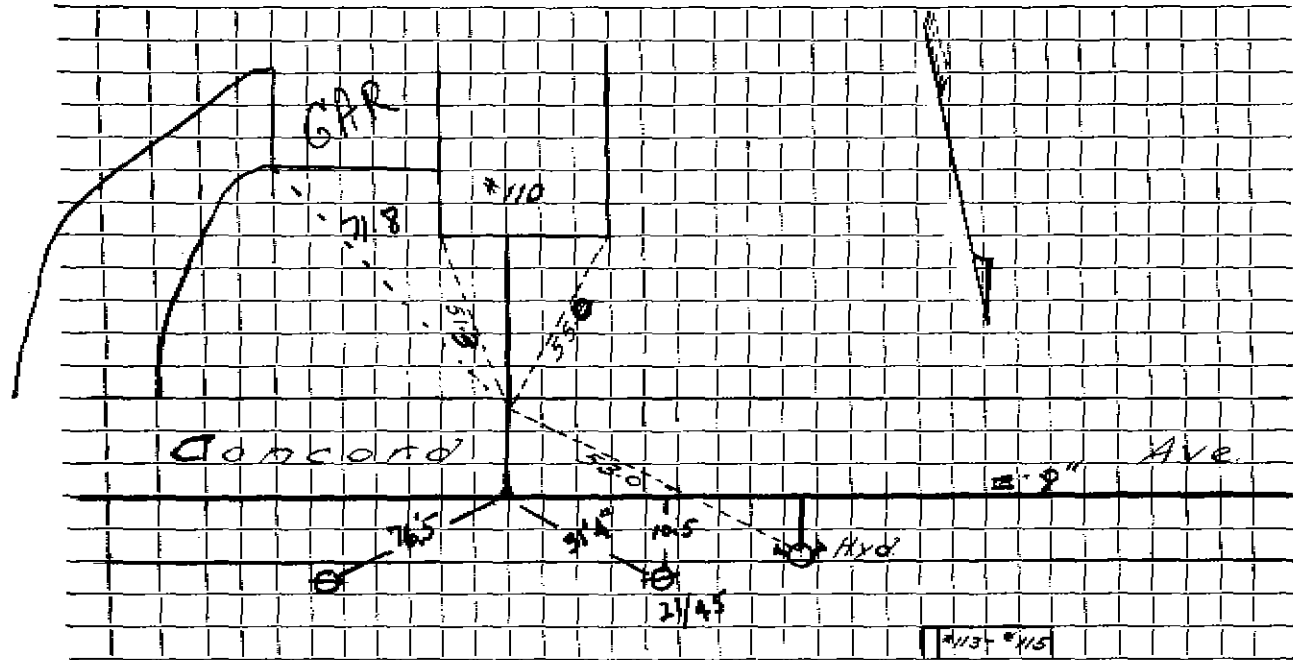

Connection made in Street. Work completed

Remarks:

.....

.....