




DATE \_\_\_\_\_

# TOWN OF LEXINGTON — BOARD OF PUBLIC WORKS

## WATER DIVISION

Sketch of Service Here

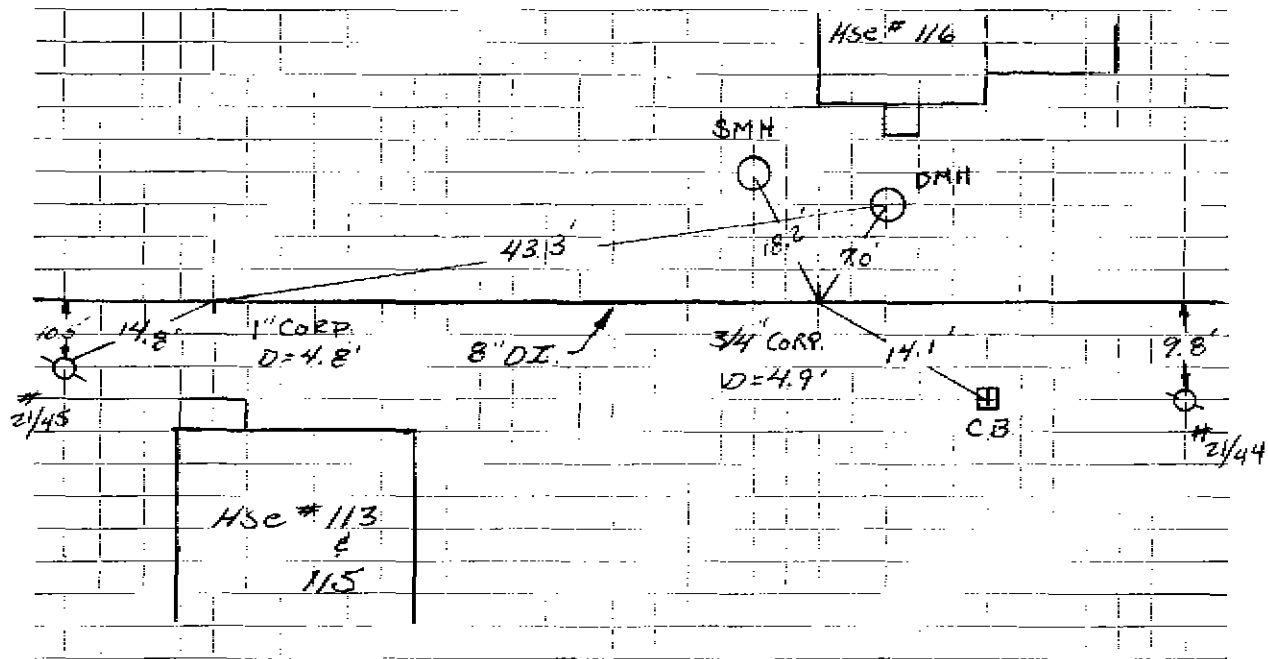

Connection made in CONCORD AVE Street. Work completed .....

Remarks: CONTRACT 82-3-E .....