

WATER SERVICE RECORD

Name

Service No. 618

Address 113 Concord Avenue

#7246

Location

~~Repair~~—Renewal—~~NEW SERVICE~~ Renew main to pit


Date	Material	Amount	Total	Date	Amount
2-12-65	Labor	80.95			
	10% C.H.	8.10	89.05		
6'	1" Copper tubing @.56		3.36	1982	NEW MAIN
1	1" Curb Cock		11.15	1	1" COP
1	2" Style 38		2.60		
1	2 x 1 Reducing Coup		1.43		
1	2 x 6 C. L. Wipple		1.04		
1	1 x 1 2 part union		2.80		
2	1" Straight tailpiece		1.86		
1	Box & rod		4.90		
8'	1" Copper tubing @.56		4.48		
			122.67		

DATE _____

TOWN OF LEXINGTON — BOARD OF PUBLIC WORKS

WATER DIVISION

Sketch of Service Here

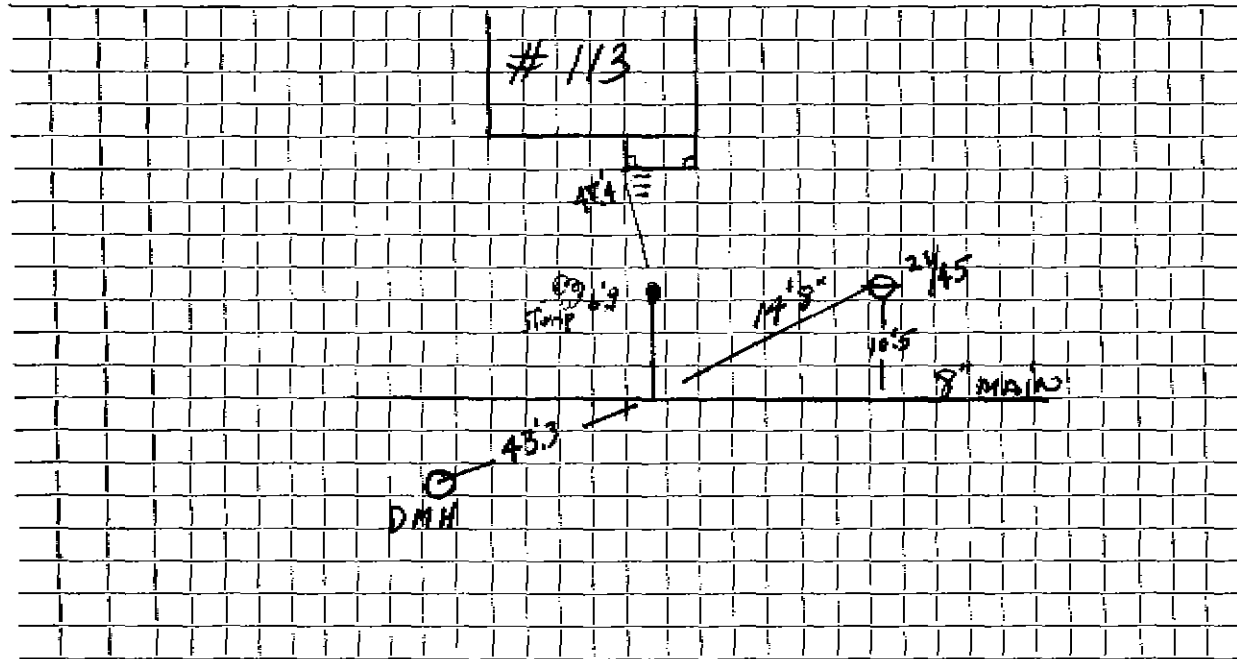

Connection made in Street. Work completed

Remarks:

.....

.....