

WATER SERVICE RECORD

Name John Murray

Service No. 57

Address 116 Concord Avenue

Location W.O.#8826

~~XXXXXXXXXXXX~~ New Service

DEC 28 1964


Date	Material	Amount	Total	Date	Amount	
7-15-64	Labor	45 45		6-9-64	Deposit	300 00
	10% O.H.	4 55	50 00	12-28-64	Retund	174 26
60'	3/4" Copper tubing @.42		25 20			125 24
1	3/4" CX 1/2 I.W.H. Stop & Waste		9 29		NON CHARGE	
1	1/2 Hr. Town Shovel @6.50		6 50		Labor	24 24
1	Hr. Trucking @3.00		3 00	32'	3/4" Copper tubing @.42	13 44
28	X 3 Patch		28 00	1	3/4" Corp Cock	7 41
			125 24	1	3/4" Curb Cock	8 76
	Repair W.O. #1409			1	Box & Rod	4 90
10-1-80	Labor			1	1/2 Straight tailpiece	50
7'	3/4" Copper tubing			1	1/2 Offset tailpiece	50
2	Style 88 3/4" Clamp			1/2	Hr. Town Shovel @6.50	3 25
	Repaired 17' 24' from main			1	Hr. Town Trucking @3.00	3 00
						66 00
				1982	NEW MAIN	
				1	3/4" Corp.	

DATE _____

TOWN OF LEXINGTON — BOARD OF PUBLIC WORKS

WATER DIVISION

Sketch of Service Here

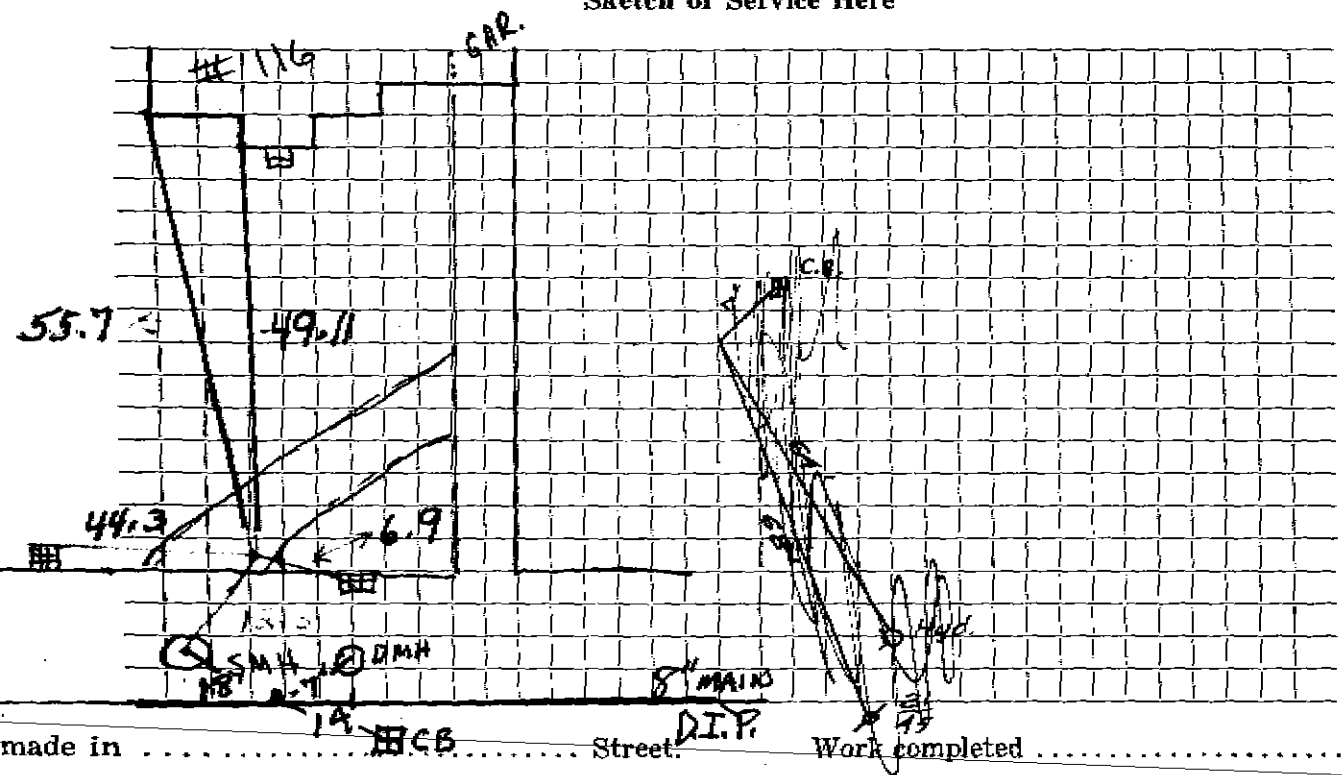

Connection made in _____ Street _____ Work completed _____

Remarks: _____

