

WATER SERVICE RECORD

Name

Service No.

Address 119 CONCORD AVE

Location PERMIT # 1382

Repair—Renewal—New Service


Date	Material	Amount	Total	Date	Amount
6/2/00	Inside			6/2/00	outside
99'	1" COPPER			1	1" COPP
1	1" 3pt UNION			13'8"	1" COPPER
99'	1" COPPER			1	1" CURB
1	1" 3pt UNION			1	BUFF BOX
20'	1" COPPER				

DATE 6/2/00

TOWN OF LEXINGTON — BOARD OF PUBLIC WORKS

WATER DIVISION

Sketch of Service Here

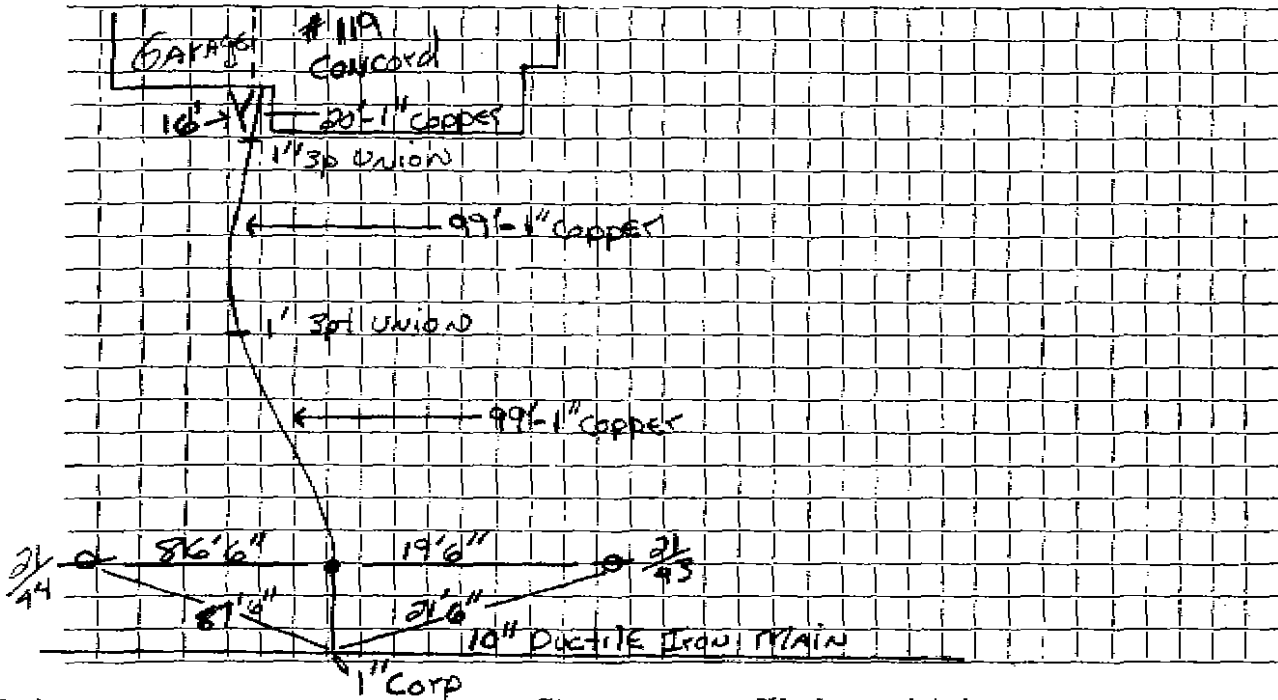

Connection made in Street. Work completed

Remarks:

.....

.....