


DATE _____

TOWN OF LEXINGTON — BOARD OF PUBLIC WORKS

WATER DIVISION

Sketch of Service Here

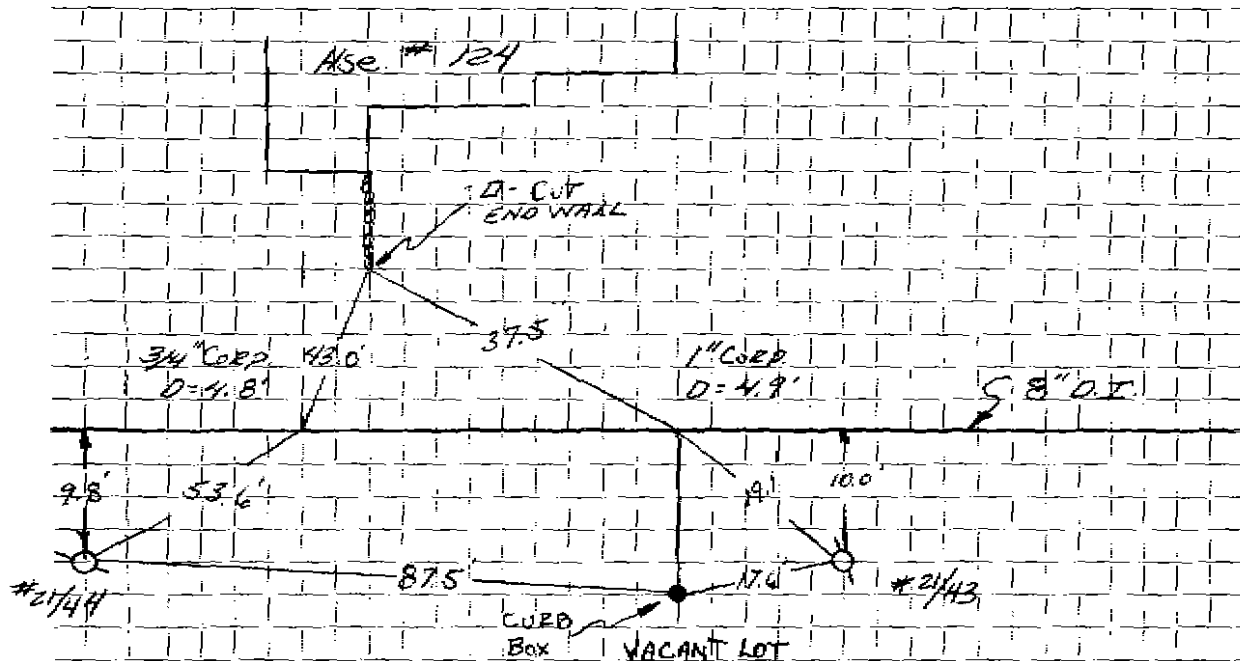

Connection made in CONCORD AVE. Street. Work completed

Remarks: CONTRACT 82-3-E

WATER SERVICE RECORD

2277

Name Murray Potter

Service No. 46

Address 124 Concord Ave

Location

~~Repair~~ ~~Renewal~~ New Service

Cond 7-5-44


Date	Material	Amount	Total	Date	Amount
4-27-60	Labor	19.82		7-5-60	Deposit 150 00
4-28-60	"	23.27	43 09	4-21-60	Retard 4 84
	10 % O.H.	4 31	47 40		<u>145 16</u>
8 1/2'	3/4" Copper tubing @ .42		35 28		
1	3/4" Cx 1/2 I.W.H. Stop & Waste		6 17		NON CHARGE
1	3/4" C 3 Part Union		2 41		Labor 13 91
3	Bags Rockwool @ 1.55		4 65	27'	3/4" Copper tubing @ .42 11 34
2 1/2	Hrs. Town Shovel @ 6.50		16 25	1	3/4" C Corp Cock 4 91
1	Hr. Trucking @ 3.00		3 00	1	3/4" C Curb Cock 6 28
	30x3 Patch		30 00	1	Box & Rod 5 00
			<u>145 16</u>	1	1/2 Straight tailpiece 50
				1	1/2 Offset tailpiece 50
				1	Hr. Trucking @ .75 75
					<u>43 19</u>

DATE _____

TOWN OF LEXINGTON — BOARD OF PUBLIC WORKS

WATER DIVISION

Sketch of Service Here

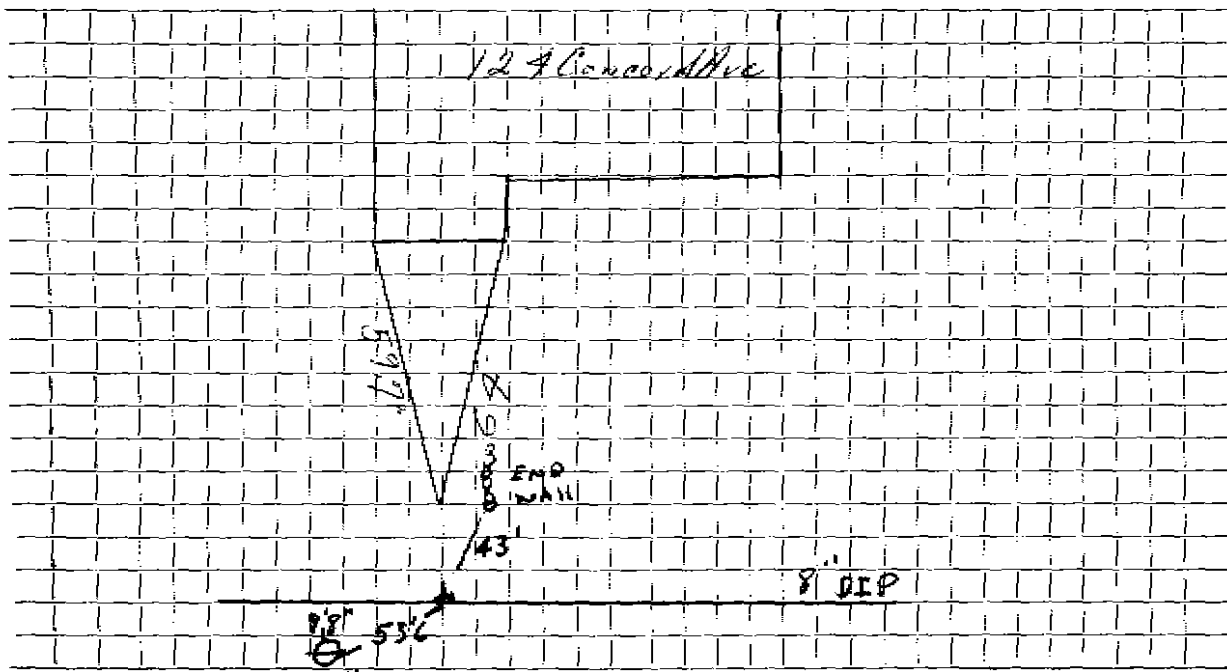

Connection made in Street. Work completed

Remarks:
.....
.....