




DATE 1/5/94

TOWN OF LEXINGTON — BOARD OF PUBLIC WORKS  
**WATER DIVISION**

Sketch of Service Here

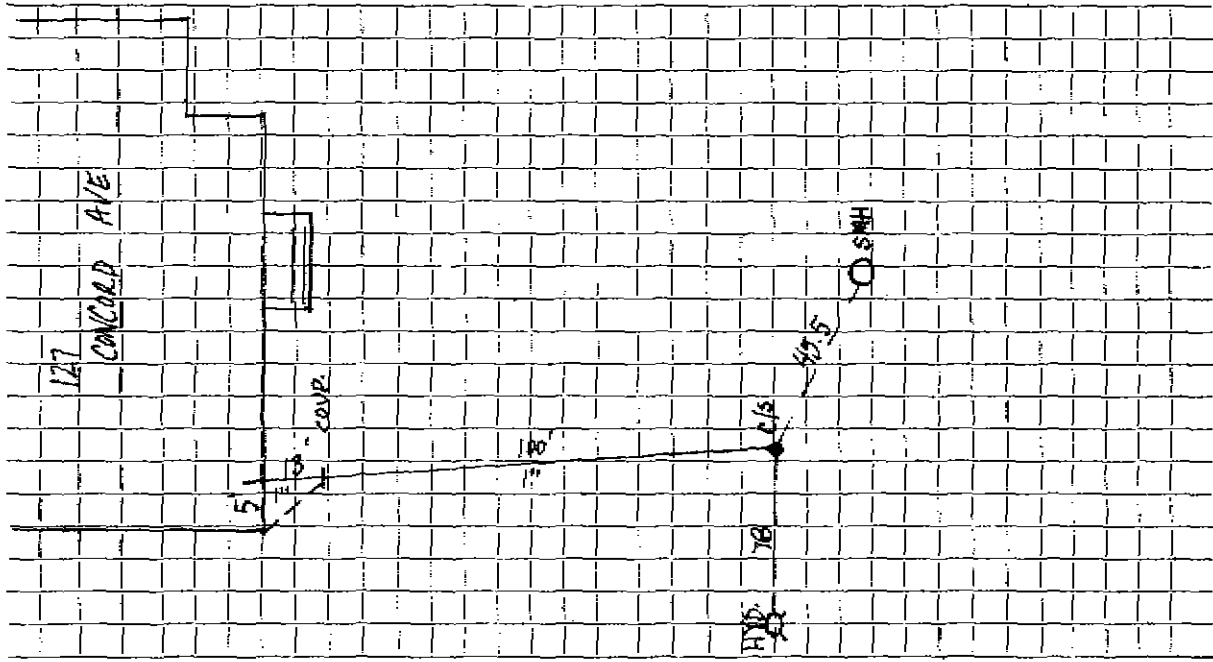

Connection made in ..... Street.

Work completed ... 6/23/93 ... E.R. BANKS .....

Remarks: .....  
.....  
.....