


Date: May 2023

TOWN OF LEXINGTON - BOARD OF PUBLIC WORKS
WATER DIVISION

SKETCH OF SERVICE HERE
130 Concord Ave

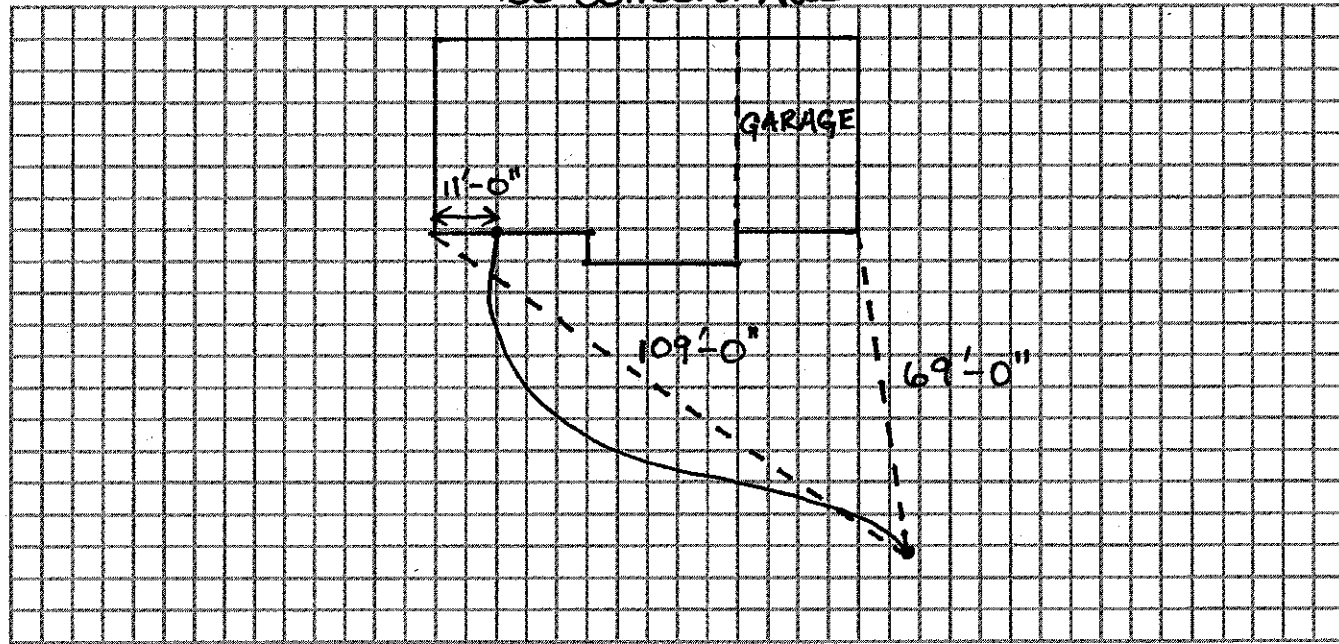

Connection made in: _____ Street. Work completed: _____
Remarks: Installed by J.M. McLaughlin Inc.