


DATE _____

TOWN OF LEXINGTON — BOARD OF PUBLIC WORKS

WATER DIVISION

Sketch of Service Here

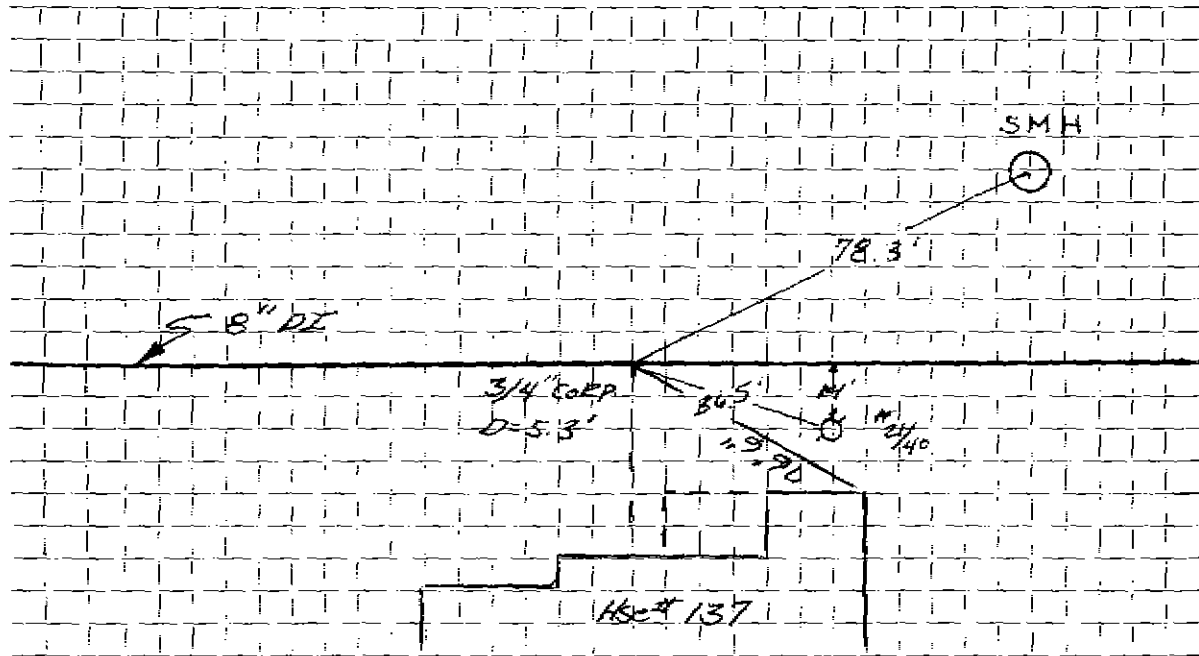

Connection made in CONCORD AVE Street. Work completed

Remarks: CONTRACT 82-3-E