

WATER SERVICE RECORD

Name

Service No.

Address

Location 143 CONCORD AVE


Repair—Renewal—New Service

Date	Material	Amount	Total	Date	Amount
1/7/55	55' 3/4 COPPER 1 3/4 x 1/2 S+W			1/7/55	7' 3/4 COPPER 1 3/4 CURB STOP Box a Rod
				1982	NEW MAIN 1 3/4 COPP

DATE _____

TOWN OF LEXINGTON — BOARD OF PUBLIC WORKS
WATER DIVISION

Sketch of Service Here

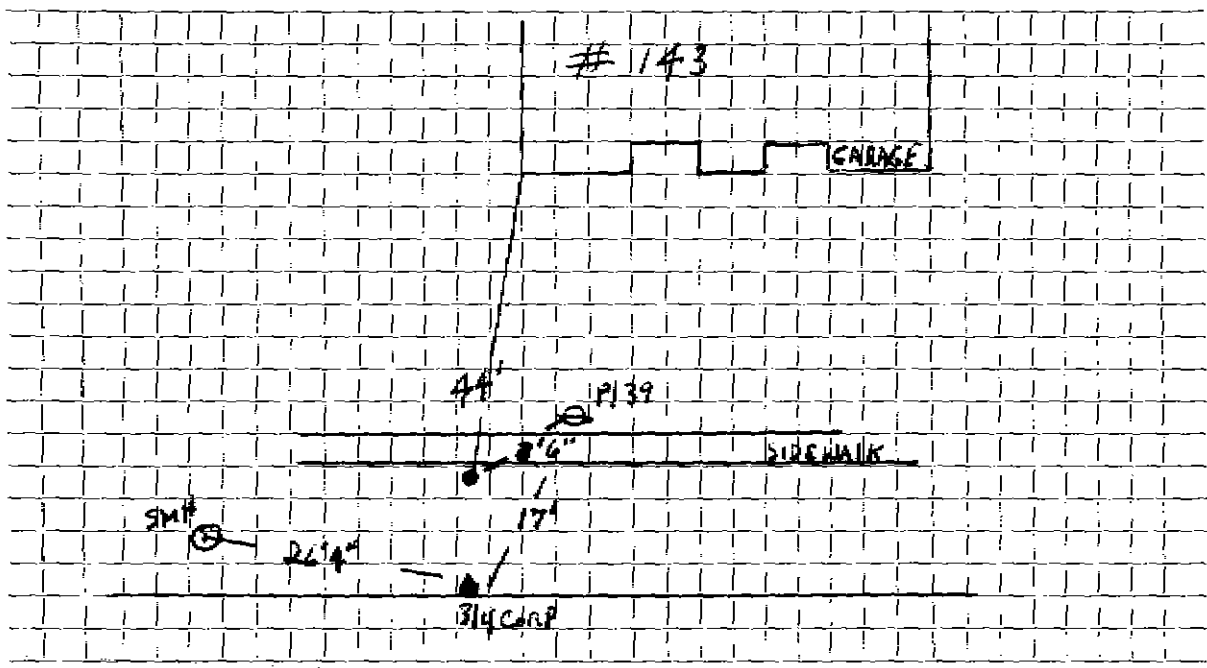

Connection made in Street. Work completed

Remarks:
.....
.....