

WATER SERVICE RECORD

#4264

Name Edward A. Lang & Son

Service No. 214

Address 144 Concord Avenue

Location

~~Repair-Renewal~~ New Service COM. 10-10-55


Date	Material	Amount	Total	Date	Amount
7/14/55	Labor	20 20		7-6-55	Deposited 100 00
	10% overhead	2 02	22 22	10-10-55	Refunded 2 31
	69'-3/4" copper tubing @ .384		26 50		<u>NON CHARGE</u> 97 69
	1-3/4" 3 part union		1 72	7/14/55	Labor 20 20
	1-3/4" Cx 1/2" IWH Stop & waste		4 00	27'-3/4" copper tubing @ .384	10 37
	20 x 3 patching		20 00	1- C Curb Cock	4 67
	1 hr. trucking @.75		75	1-Box & Rod	3 90
	3 hrs. Littlefield Shovel @ 7.50		22 50	1-1/2" straight tail piece	50
			97 69	1-1/2" offset tail piece	50
				1 hr. trucking @.75	75
				2-2/3 hrs. Littlefield Shovel @ 7.50	20 00
					60 89
				1982	NEW 8" MAIN
					1 3/4 CORP

DATE _____

TOWN OF LEXINGTON — BOARD OF PUBLIC WORKS

WATER DIVISION

Sketch of Service Here

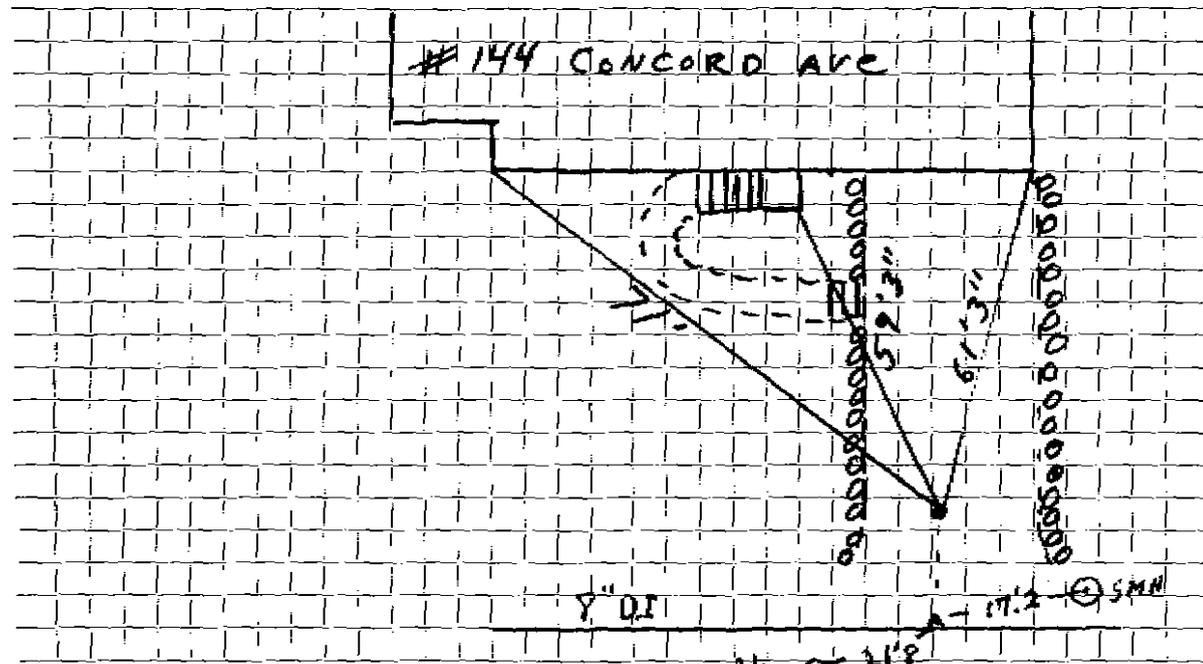

Connection made in Street. Work completed

Remarks: 1992 3/4 G.P. NEW MAIN

.....

.....