




DATE \_\_\_\_\_

TOWN OF LEXINGTON — BOARD OF PUBLIC WORKS

**WATER DIVISION**

Sketch of Service Here

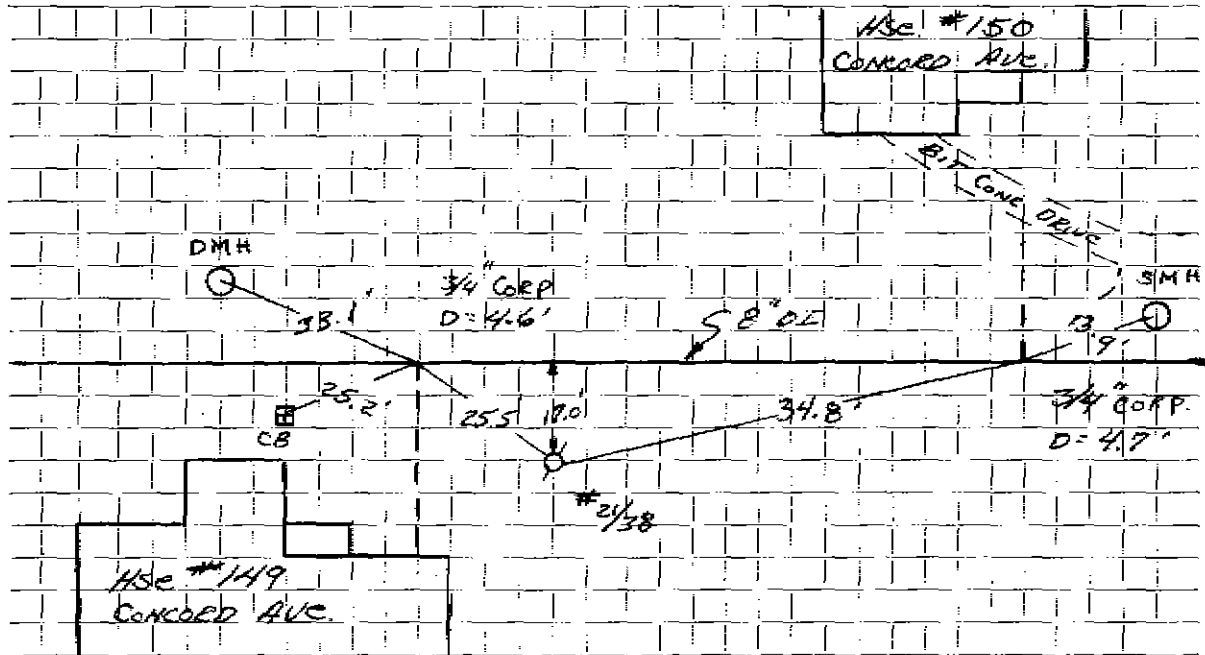

Connection made in CONCORD AVE. Street. Work completed 3/30/82

Remarks: 13' of 3/4" Copper Re-laid & lowered @ Hse #150. ducta. possible freezing.