

WATER SERVICE RECORD

Name Louis Ciampa

Service No. 42

Address 119 Concord Avenue

#7209

Location \_\_\_\_\_

~~Repair~~ ~~Renewal~~ ~~New Service~~

Com. 5-3-54

Date	Material	Amount	Total	Date	Amount
4/2/54	Labor	10 10		3-10-54	65 00
	10% overhead	1 01	11 11	5-3-54	4 92
	10' 3/4" Copper tubing @ .35	11 08			20 08
	1-2/4" Cx 1/2 I.W.F. Stop waste	1 00			
	1-3/4" Cx 3/4 C-Union (3 parts)	1 72		4/2/54	10 10
	3 hrs Littlefield shovel @ 7.50	22 50		8'-3/4" Copper tubing @ .35	2 80
	patching 6 x 3	8 00		1-3/4" 3/4 curb cock	4 33
	1 hr. trucking	7 00		1-3/4" 3/4 C curb cock	4 67
		60 08		1 box & rod	3 90
				1-1/2 straight tail piece	50
				1-1/2 offset tail piece	50
				1 hr. Littlefield shovel	7 50
				1 hr trucking	75
					35 05


1972 3/4 CORP

DATE \_\_\_\_\_

TOWN OF LEXINGTON — BOARD OF PUBLIC WORKS

WATER DIVISION

Sketch of Service Here

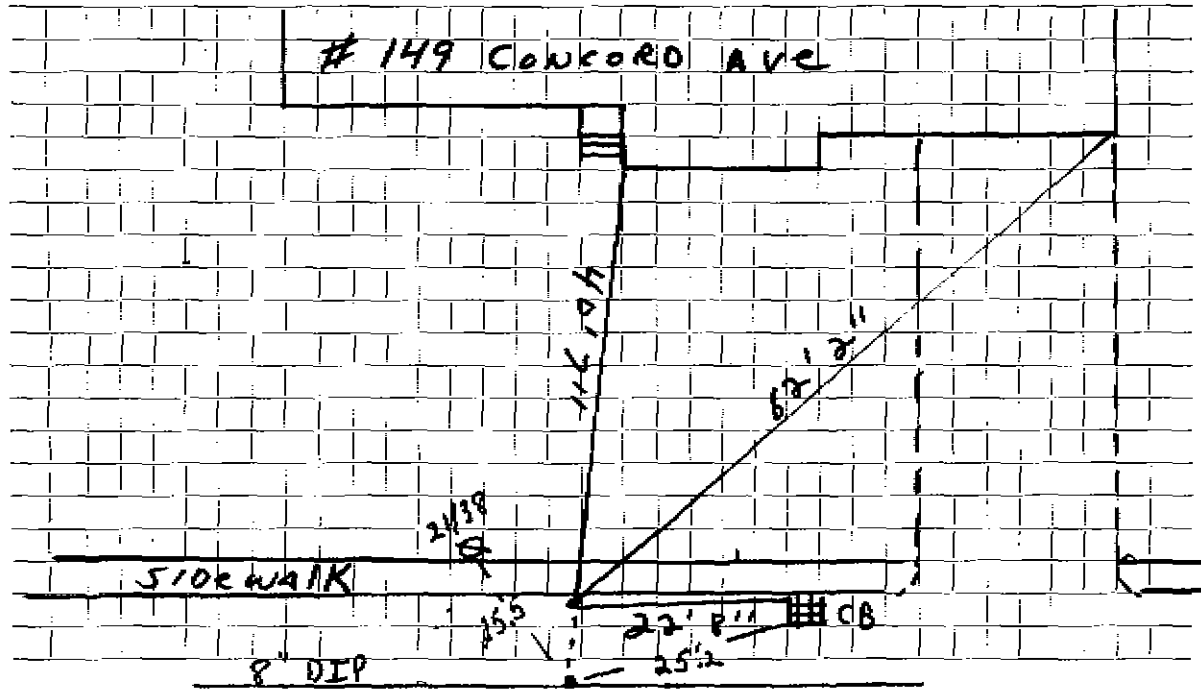

Connection made in ..... Street. Work completed .....

Remarks: *curb in st.* .....

.....  
.....