


TOWN OF LEXINGTON — BOARD OF PUBLIC WORKS
WATER DIVISION

Sketch of Service Here

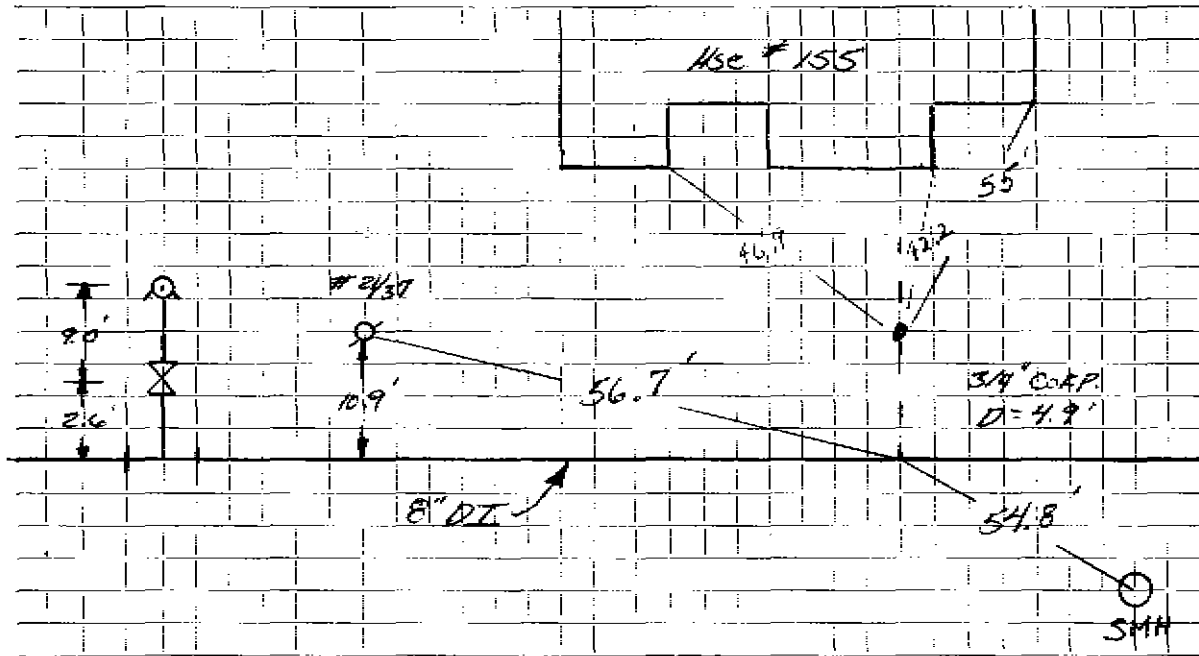

Connection made in CONCORD AVE. Street. Work completed

Remarks:

.....

.....