


TOWN OF LEXINGTON — BOARD OF PUBLIC WORKS

WATER DIVISION

Sketch of Service Here

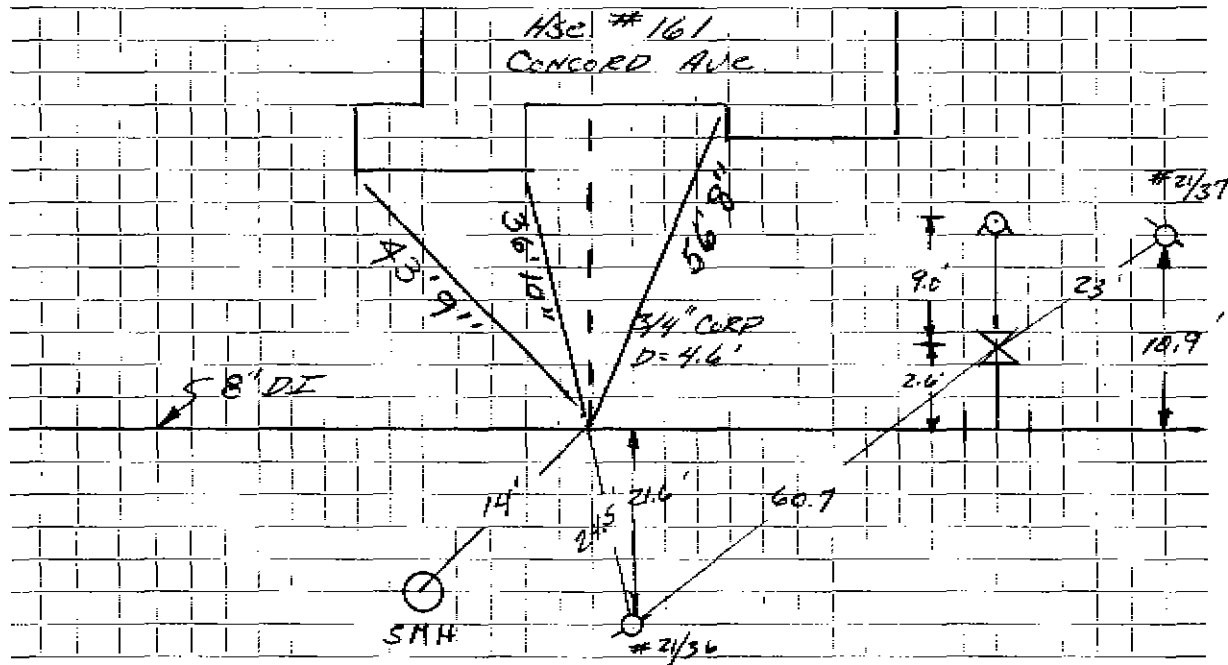

Connection made in CONCORD AVE. Street. Work completed 3/24/82.

Remarks:

.....

.....