


DATE _____

TOWN OF LEXINGTON — BOARD OF PUBLIC WORKS

WATER DIVISION

Sketch of Service Here

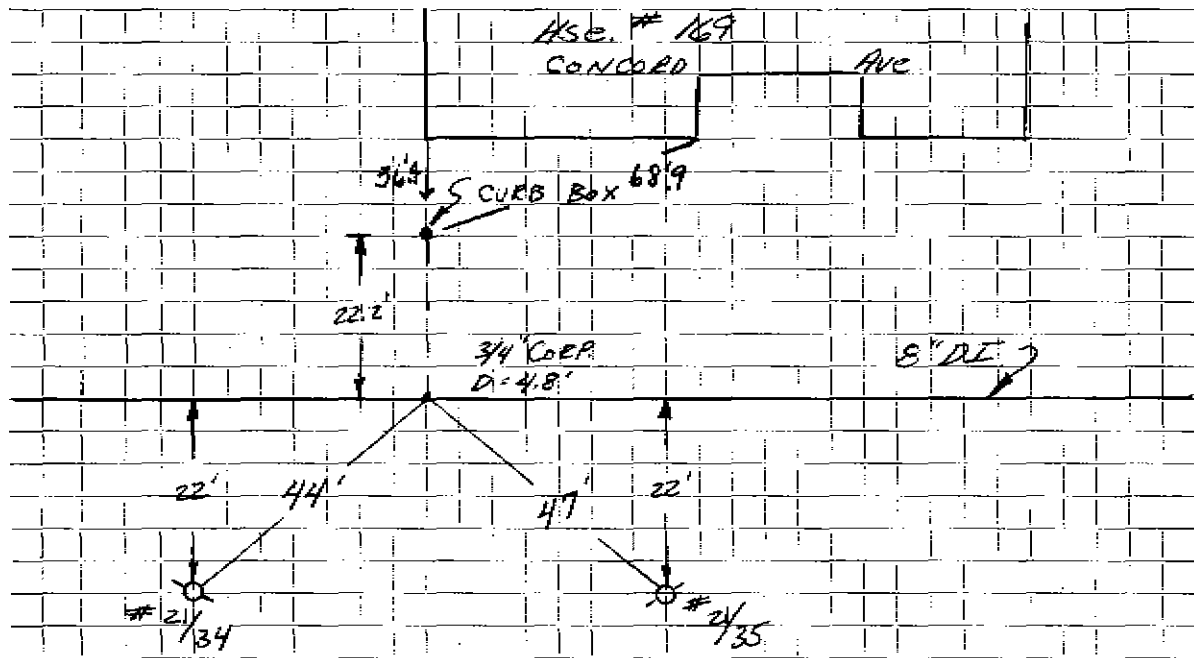

Connection made in ... CONCORD AVE ... Street ... Work completed ... 3/24/82 ...

Remarks:

.....

.....