

WATER SERVICE RECORD

5806

Name Deran Dedekian

Service No.

297

Address 170 Concord Avenue

Location

~~Repair - Renewal~~ - New Service


Date	Material	Amount	Total	Date	Amount
10/9/56	Labor	19 50		9-24-56	Deposit \$ 125 00
	10% overhead	1 95	21 45	12-31-56	Refund 41 59
	50' - 3/4" Copper tubing @ .4850	24 25			NON CHARGE \$ 83 41
	1 - 3/4" Cx 1/2 I.W.H. Stop & Waste	4 96		10/9/56	Labor 9 50
	1 hr. trucking		75	24' - 3/4" Copper tubing @ .4850	11 64
	Patching		15 00	1 - 3/4" C. Corp Cock	4 64
	2 hrs. Littlefield Shovel @ 8.50	17 00		1 - 3/4" C. Curb Cock	5 94
			83 41	1 Box & Rod	4 62
				1 - 1/2 Straight tailpiece	50
				1 - 1/2 Offset tailpiece	50
				2 hrs. Littlefield Shovel @ 8.50	17 00
					54.34

DATE _____

TOWN OF LEXINGTON — BOARD OF PUBLIC WORKS

WATER DIVISION

Sketch of Service Here

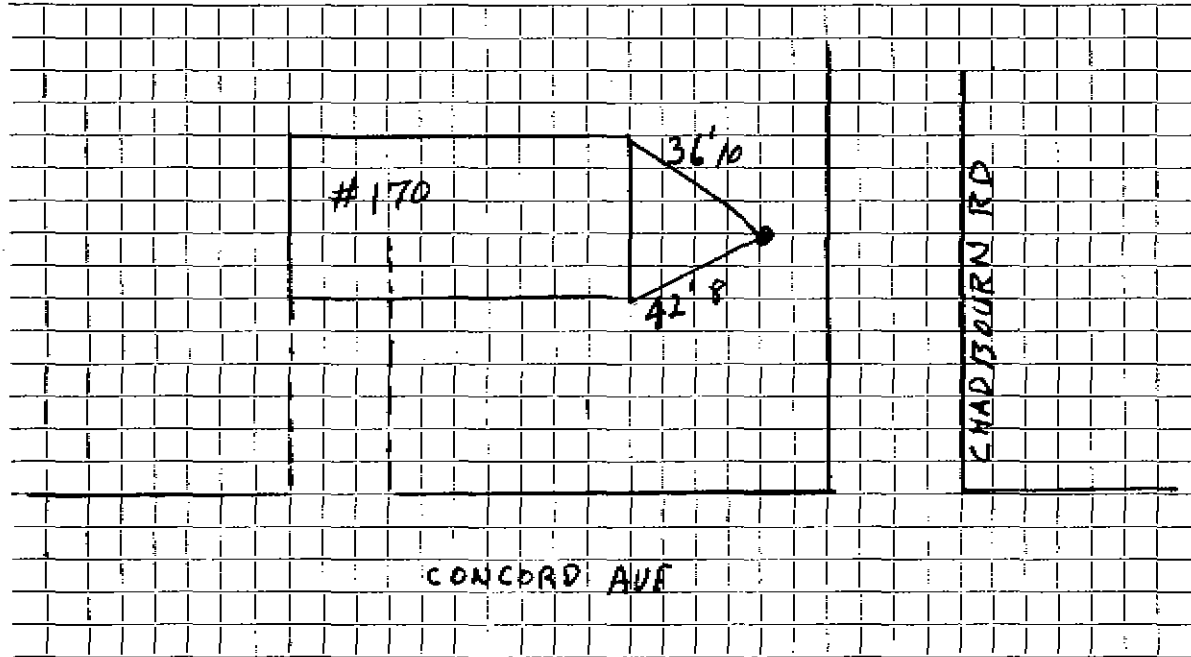

Connection made in Street. Work completed

Remarks:

.....

.....