


DATE _____

TOWN OF LEXINGTON — BOARD OF PUBLIC WORKS

WATER DIVISION

Sketch of Service Here

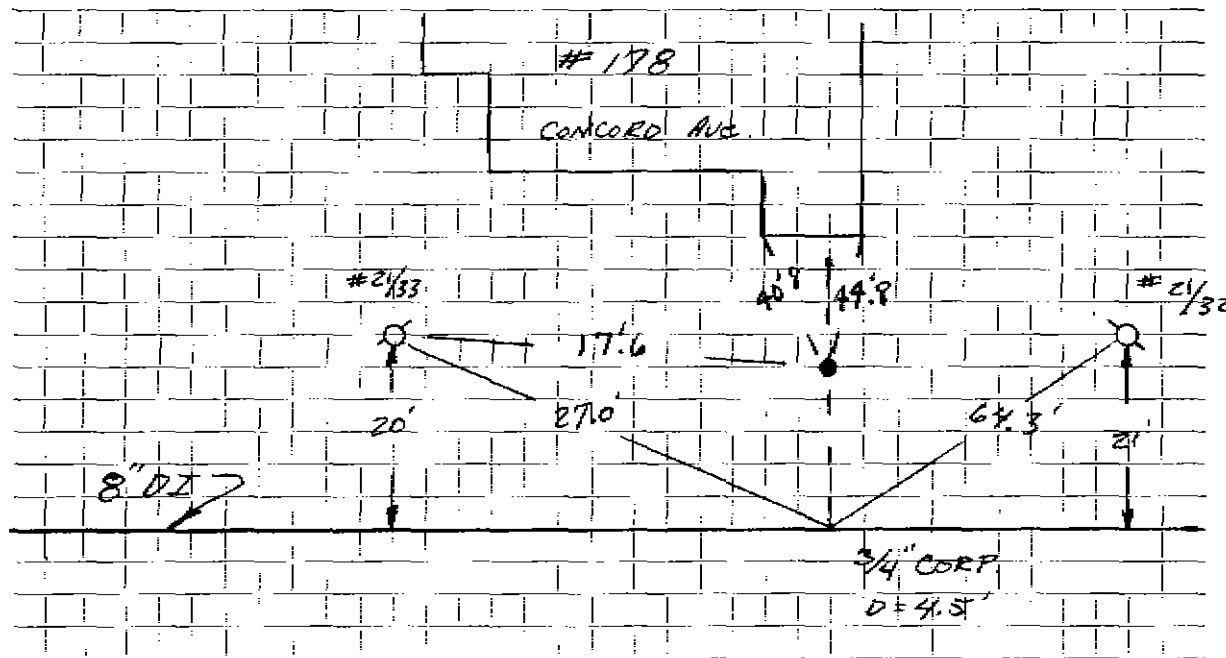

Connection made in CONCORD AVE Street. Work completed 3/17/82

Remarks: 15' Removed & Re-laid due to Lack of Depth