


DATE 9/95

TOWN OF LEXINGTON — BOARD OF PUBLIC WORKS
WATER DIVISION

Sketch of Service Here

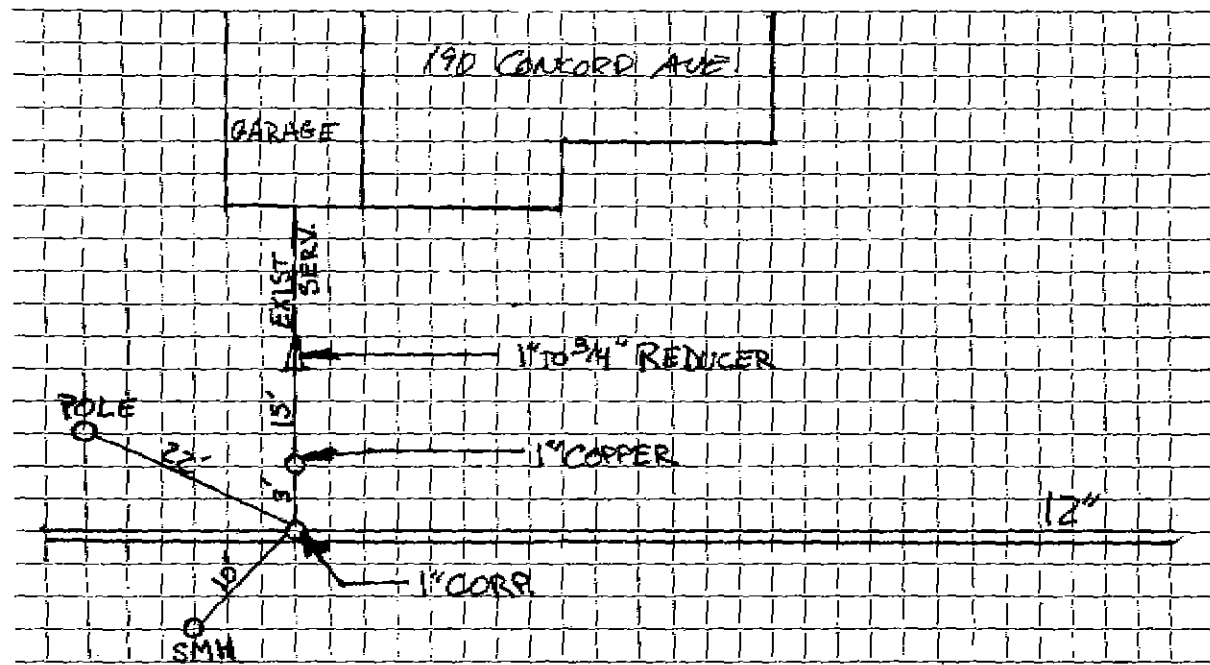

Connection made in Street. Work completed

Remarks:
.....
.....

WATER SERVICE RECORD

Name Ernest Oman

Service No. 275

Address 190 Concord Ave.

Location Lexington

~~Water~~ - New Service

Com. 11-24-52


Date	Material	Amount	Total	Date	Amount
10/24/52	Labor	9 17		10-20-52	Deposited 75 00
	10% overhead	92	10 09	11-24-52	Refunded (8 76)
	60' - 3/4" copper tubing@ .34	20 40			<u>NON CHARGE</u> 26 24
	1 -3/4" C x 1/2 I.W.H.stop& waste	4 00		10/24/52	Labor 9 17
	3 hrs. Littlefield shovel		21 00	10' - 3/4" copper tubing@ .34	3 40
	1 hr. trucking		75	1 - 3/4" C. corp-cock	4 33
	patching 10 x 3		10 00	1 -3/4" C x 3/4" C.curb-cock	4 67
			66 24	1 box and rod	3 90
				1 -1/2 offset tail piece	50
				1 -1/2 straight tail piece	50
				1 hr. Littlefield shovel	7 00
				1 hr. trucking	75
					<u>34 22</u>

DATE _____

TOWN OF LEXINGTON — BOARD OF PUBLIC WORKS

WATER DIVISION

Sketch of Service Here

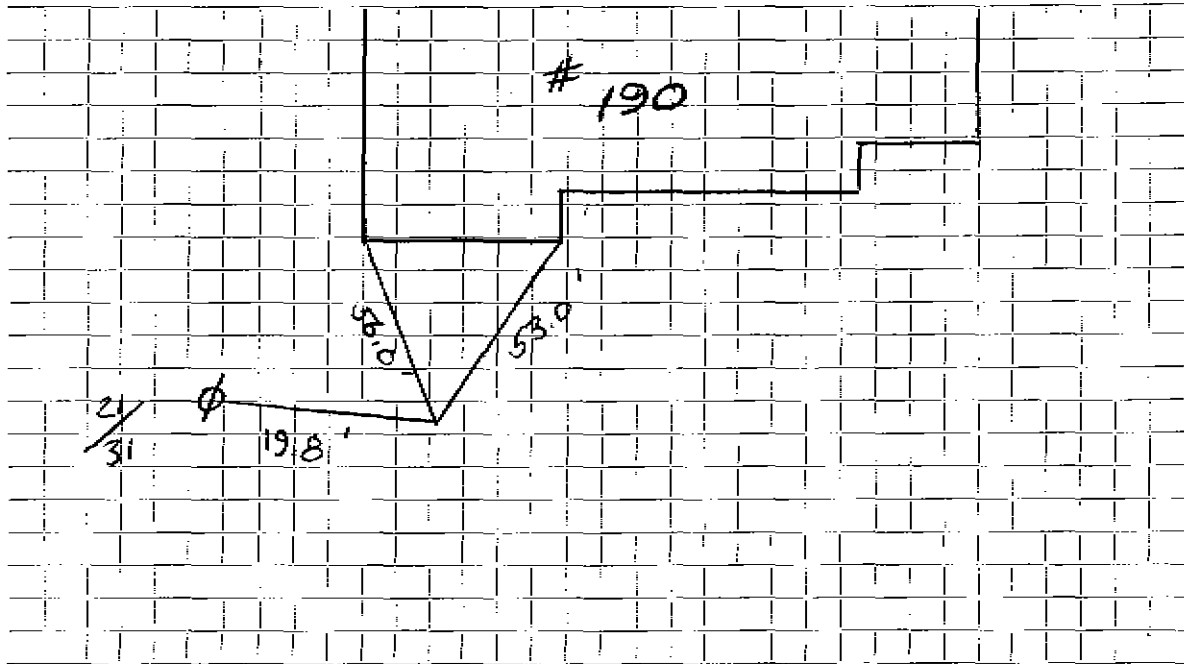

Connection made in Street. Work completed

Remarks:
.....
.....