


Date: 9/23/22

TOWN OF LEXINGTON - BOARD OF PUBLIC WORKS
WATER DIVISION

SKETCH OF SERVICE HERE

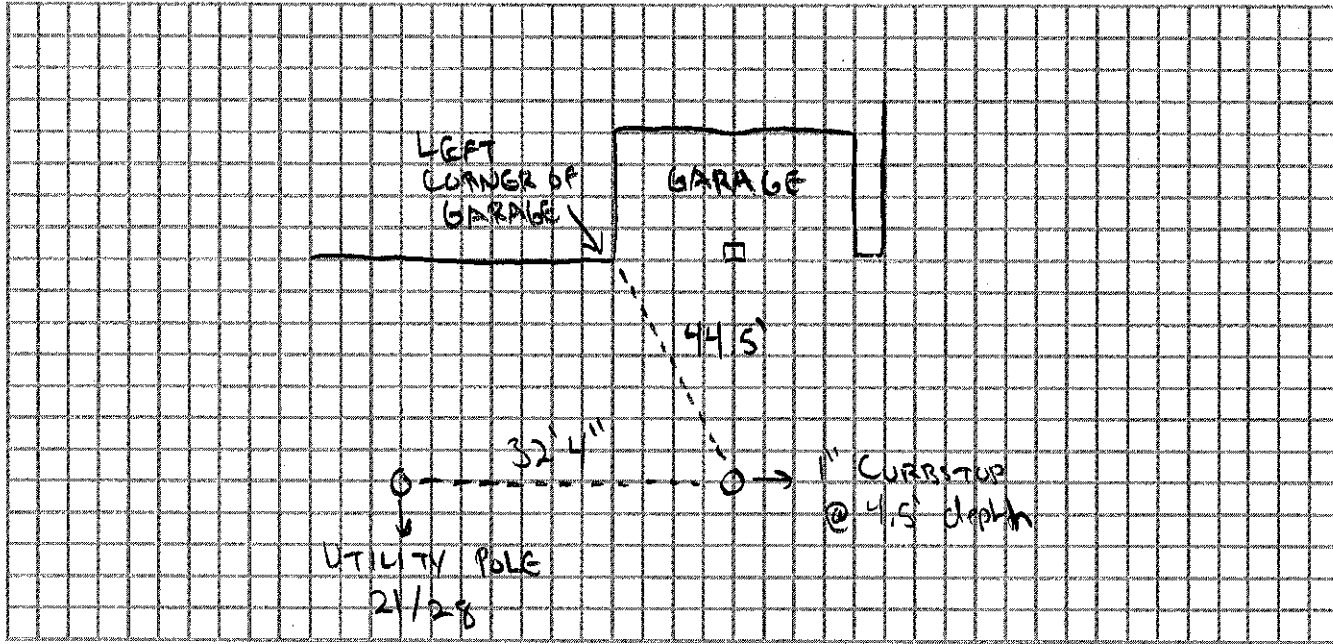

Connection made in:

Street.

Work completed:

Remarks: INSTALLED BY J.W. SULLIVAN CORP.