




Date: 6/2/2023

TOWN OF LEXINGTON - BOARD OF PUBLIC WORKS  
WATER ~~SEWER~~ DIVISION

SKETCH OF SERVICE HERE

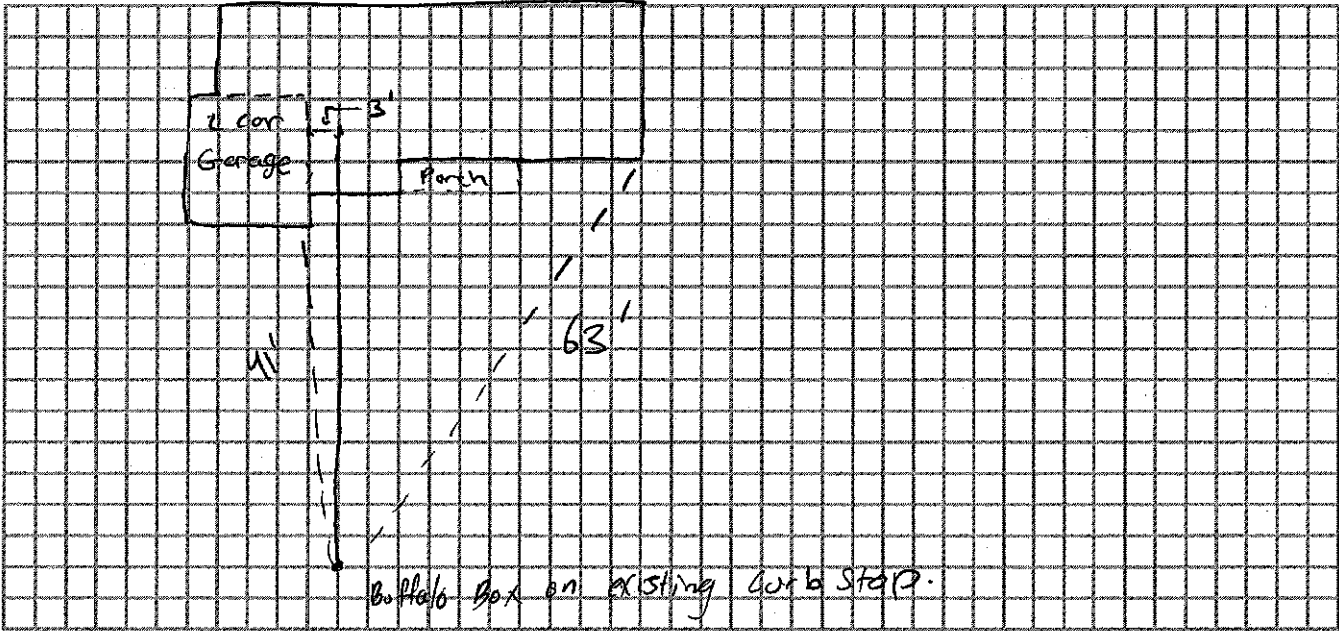

Connection made in: 212 concord ave Street. Work completed:  
Remarks: Ferguson Water Works